


WELL PLUGGING RECORD

Give All Information Completely
Make Required Affidavit
Mail or Deliver Report to:
Conservation Division
State Corporation Commission
800 Bitting Building
Wichita, Kansas

NORTH

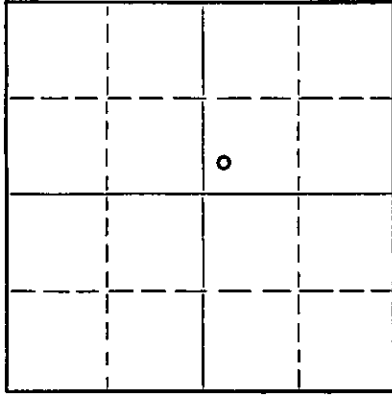

Locate well correctly on above
Section Plat

Elldworth County, Sec. 8 Twp. 14 Rge. 10 (E).....(W)
Location as "NE/CNW $\frac{1}{4}$ /SW $\frac{1}{4}$ " or footage from lines SW SW NE
Lease Owner Stag Drilling, Incorporated
Lease Name Kuch Well No. 1
Office Address Chase, Kansas
Character of Well (completed as Oil, Gas or Dry Hole) Abandoned Oil Well
Date well completed May 1, 1950 19.....
Application for plugging filed March 6, 1952 19.....
Application for plugging approved March 11, 1952 19.....
Plugging commenced 3-8-52 19.....
Plugging completed 3-21-52 19.....
Reason for abandonment of well or producing formation oil depleted

If a producing well is abandoned, date of last production..... 19.....
Was permission obtained from the Conservation Division or its agents before plugging was commenced?..... Yes

Name of Conservation Agent who supervised plugging of this well..... Ruell Durkee
Producing formation..... Depth to top..... Bottom..... Total Depth of Well..... Feet
Show depth and thickness of all water, oil and gas formations.

OIL, GAS OR WATER RECORDS

CASING RECORD

Formation	Content	From	To	Size	Put In	Pulled Out
				8-5/8"	260'	None
				5-1/2"	3352'	2567'

Describe in detail the manner in which the well was plugged, indicating where the mud fluid was placed and the method or methods used in introducing it into the hole. If cement or other plugs were used, state the character of same and depth placed, from..... feet to..... feet for each plug set.

Rocked hole from 3330' to 3280' and ran 6 sacks of cement. Bailed off fluid and mudded hole to 250'. Set 10' rock bridge and ran 15 sacks of cement. Mudded hole to 35', set rock bridge and ran 5 sacks of cement. Plugging completed.

03-27-52

(If additional description is necessary, use BACK of this sheet)

Name of Plugging Contractor West Supply Company
Address Chase, Kansas

STATE OF Kansas, COUNTY OF Rice, ss.
Ed. Tyrrell (employee of owner) or (owner or operator) of the above-described well,

being first duly sworn on oath, says: That I have knowledge of the facts, statements, and matters herein contained and the log of the above-described well as filed and that the same are true and correct. So help me God.

(Signature) E. L. Tyrrell, Pres.
(Address)

SUBSCRIBED AND SWORN to before me this 26 day of Mar, 1952

My commission expires 3/1/55 Wanda Miller Notary Public.

8-14-10W
119-1-15