


STATE OF KANSAS
STATE CORPORATION COMMISSION

Give All Information Completely
Make Required Affidavit
Mail or Deliver Report to
Conservation Division
State Corporation Commission
245 North Water
Wichita, KS 67202

FORM CP-4

WELL PLUGGING RECORD

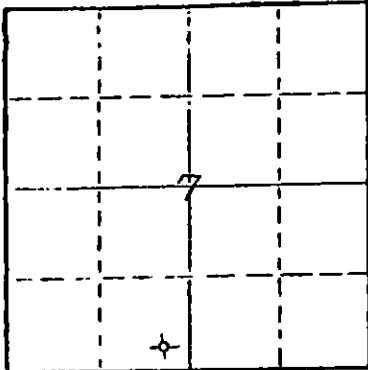

Locate well correctly on above
Section Plot

Ellsworth County, Sec. 7 Twp. 14S Rge. (E) 10 (W)
Location as "NE/CNWKSW" or footage from lines SE SW SW
Lease Owner Mack Oil Co.
Lease Name Vancura Well No. 1
Office Address 812 Union Center, Wichita, KS 67202
Character of Well (completed as Oil, Gas or Dry Hole) dry hole
Date well completed 3-22-76 19
Application for plugging filed 3-31-76 19
Application for plugging approved 3-22-76 19
Plugging commenced 3-22-76 19
Plugging completed 3-22-76 19
Reason for abandonment of well or producing formation dry hole

If a producing well is abandoned, date of last production 19
Was permission obtained from the Conservation Division or its agents before plugging was commenced? YES

Name of Conservation Agent who supervised plugging of this well Gilbert Toman, Hollyrood, KS
Producing formation _____ Depth to top _____ Bottom _____ Total Depth of Well 3331' Feet
Show depth and thickness of all water, oil and gas formations.

OIL, GAS OR WATER RECORDS

CASING RECORD

FORMATION	CONTENT	FROM	TO	SIZE	PUT IN	PULLED OUT
				8 5/8"	258'	

Describe in detail the manner in which the well was plugged, indicating where the mud fluid was placed and the method or methods used in introducing it into the hole. If cement or other plugs were used, state the character of same and depth placed, from _____ feet to _____ feet for each plug set.

Plugged @ 500' w/40 sx. cement
@ 260' w/25 sx.
@ 40' w/10 sx.
2 sx. in rathole

04-01-76

Name of Plugging Contractor (If additional description is necessary, use BACK of this sheet)
Thomas Drilling Co.
Address P. O. Box 400, Duncan, OK 73533


STATE OF Kansas COUNTY OF Sedgwick ss.
Harry A. Larsh (employee of owner) or (owner or operator) of the above-described well, being first duly sworn on oath, says: That I have knowledge of the facts, statements, and matters herein contained and the log of the above-described well as filed and that the same are true and correct. So help me God.

(Signature) *Harry A. Larsh*
812 Union Center, Wichita, KS
(Address)

SUBSCRIBED AND SWORN TO before me this 31st day of March, 1976

My Commission Expires Jan. 8, 1978

Nancy Laggart
Nancy Laggart, Notary Public.

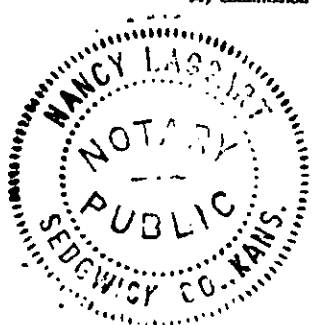

MACK OIL COMPANY
Wichita, Kansas
67202

DRILLER'S WELL LOG

#1 Vancura

SE SW SW - Sec. 7-14S-10W

Ellsworth County, Kansas

Commenced R.D. 3-17-76

Elevation: 1749' KB, 1740' GL

Completed R.D. 3-22-76

Dry & Abandon

Rotary Total Depth: 3331'

Contractor: Thomas Drilling Co.

<u>STRATA</u>	<u>DEPTH</u>
Surface Sand	450
Redbed	550
Anhydrite	580
Shale & Shell	1190
Lime & Shale	1825
Shale & Lime	2130
Lime & Shale	2360
Lime	3331 RTD

Depth indicated bottom of formations

I hereby certify that the above is a true and correct log of said well as reflected by the daily drilling reports.

MACK OIL CO.

BY

Harry A. Larsh

Harry A. Larsh

Signed and sworn to in my presence this 31st day of March, 1976,
by Harry A. Larsh, representative of Mack Oil Co.

My Commission Expires Jan. 8, 1978

Nancy Laggart

Nancy Laggart
Notary Public

