

STATE OF KANSAS
STATE CORPORATION COMMISSION

Give All Information Completely
Make Required Affidavit
Mail or Deliver Report to:
Conservation Division
State Corporation Commission
212 No. Market
Wichita, Kansas


Form CP-4

15-053-20079-00-00
WELL PLUGGING RECORD

ELLSWORTH

County, Sec. 1 Twp. 14 Rge. 10 (E) (W) West

Location as "NE/CNW/SW" or footage from lines Center of SE 4
Lease Owner Ehrlich Drilling Company
Lease Name Kratky Well No. 1
Office Address P. O. Box 173, Wilson, Kansas 67490
Character of Well (completed as Oil, Gas or Dry Hole) Dry hole
Date well completed March 7 19 69
Application for plugging filed July 14 19 69
Application for plugging approved 19
Plugging commenced April 8, 10 a. m. 19 69
Plugging completed April 8, 12 noon 19 69
Reason for abandonment of well or producing formation dry hole.

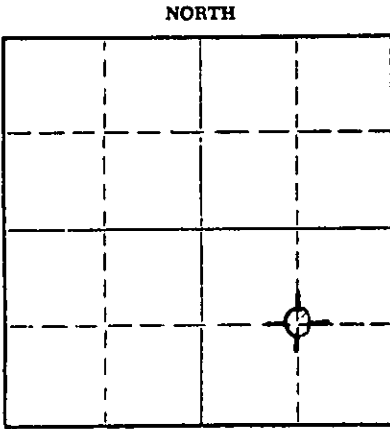

Locate well correctly on above Section Plat

If a producing well is abandoned, date of last production 19
Was permission obtained from the Conservation Division or its agents before plugging was commenced? yes, verbally.

Name of Conservation Agent who supervised plugging of this well Gilfort Tollman Gilbert Toman, Holyrood, Kansas
Producing formation none Depth to top Bottom Total Depth of Well 2916 Feet
Show depth and thickness of all water, oil and gas formations.

OIL, GAS OR WATER RECORDS

CASING RECORD

FORMATION	CONTENT	FROM	TO	SIZE	PUT IN	PULLED OUT
surface water		70	85	8 5/8	154	none
	Surface casing cemented by Globe Oil Well Cementing Co. Great Bend, Kansas 67530 on February 6, 1969, by their invoice # 12003					
oil & gas	none					

Describe in detail the manner in which the well was plugged, indicating where the mud fluid was placed and the method or methods used in introducing it into the hole. If cement or other plugs were used, state the character of same and depth placed, from feet to feet for each plug set.

Filled hole with drilling mud with rotary mud pump.
First plug set at 180 feet with 25 sacks of common cement.
Second plug set at 40 feet with hulls and 10 sacks of common cement.

Pump plugging of cement by Globe Oil Well Cementing, Inc., Great Bend, Kansas, on April 8, 1969, by their invoice # 14356.

The plugging was under the supervision of Gilfort Tollman.

RECEIVED
STATE CORPORATION COMMISSION
AUG 1 1969
CONSERVATION DIVISION
Wichita, Kansas

(If additional description is necessary, use BACK of this sheet)
Name of Plugging Contractor Ehrlich Drilling Company
Address P. O. Box 173, Wilson, Kansas 67490


STATE OF KANSAS COUNTY OF ELLSWORTH, ss.
R. B. Schmidt, consulting geologist (employee of owner) or (owner or operator) of the above-described well, being first duly sworn on oath, says: That I have knowledge of the facts, statements, and matters herein contained and the log of the above-described well as filed and that the same are true and correct. So help me God.

(Signature) R. B. Schmidt
1219 College Avenue, Topeka, Kansas 66604
(Address)

SUBSCRIBED AND SWORN TO before me this 15th day of July 19 69

My Commission Expires Nov. 5, 1971

Edward S. Greiner
Notary Public.

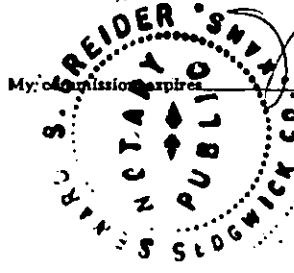

15-053-20079-00-00

RECEIVED
STATE CORPORATION COMMISSIONNO. 1 KRATKYJUL 30 1969
CONSERVATION DIVISION
Wichita, Kansas

Well Log:

Location: Center of the Southeast Quarter of Section one (1), Township 14 S. Range 10 West, Ellsworth County, Kansas. Commenced: February 5, 1969

Operator: Ehrlich Drilling Company & Bob Craig P. O. Box 173 Wilson, Kansas Completed: March 7, 1969 (Rotary) Plugged: April 8, 1969

Contractor: Ehrlich Drilling Company P. O. Box 173 Wilson, Kansas 67490 Elevation: 1680 K. B. Production: D & A

Casing Record: 8 - 5/8th inch O 154 feet with 75 sacks of common cement.

- - - - L O G - - - -

(Figures indicate bottom of formation)

Clay	30	Lime & Clay	2379
Sand	40	Shaley lime	2418
Clay	50	Lime	2585
Sand	60	Shale	2589
Shale & Clay	185	Lime	2671
Red Bed	266	Black Shale	2675
Red Bed & Shale	385	Lime	2718
Iron	403	Green shale, tan chert	
Clay & Shale	533	white sand(fine), brown	
Shale, Shells	630	shale	2767
Salt	956	Brown shale & lime	2785
Shale & Salt	1114	Clay & shale	2794
Gray Anhydrite	1220	Tan, white & foss	
Lime & Sand	1320	lime	2810
Multi color Clay	1368	Hard gry & tan	
Lime (Grey-White)	1460	cherty lime	2818
Shale	1488	Dense oolitic lime	
Lime & Shale	1680	with chalk matrix in partial	
Lime	1789	developed oolitic lime,	
Shale	1794	buff to white	2837
Lime & Shale	1991	Dense gray hard	
Sandstone	1998	cherty lime	2844
Clay	2008	Shale	2846
Chert	2019	White y xyn lime	
Shale & red rock	2052	dense to chalky	2874
Lime	2058	Buff & white lime	2880
Sand	2070	Lime chalky	2894
Lime	2075	Oolitic to oolitic	
Sand & Shale	2130	lime, white	2906
Lime	2157	Lime, chalky	2912
Sand & Shale	2196	Lime, cherty, tan	2916 R. T. D.
Lime	2250		
Shale	2340		

The undersigned, EHRLICH DRILLING COMPANY & BOB CRAIG, hereby certify that the above log is a true and correct log of the formations encountered in drilling the above well as reflected by the daily drilling reports.

State of Kansas)
COUNTY of Sedgwick) ss.
Subscribed and a sworn to before me this
30th day of July, 1969.

EHRLICH DRILLING COMPANY & BOB CRAIG,

By: Richard B. Schmidt, geologist for

Richard B. Schmidt
Julius Ehrlich, Tom Ehrlich, Bob Craig,
OPERATOR

My commission expires: 11-26-70