


STATE OF KANSAS
STATE CORPORATION COMMISSION

WELL PLUGGING RECORD

Give All Information Completely
Make Required Affidavit
Mail or Deliver Report to
Conservation Division
State Corporation Comm.
245 North Water
Wichita, KS 67202

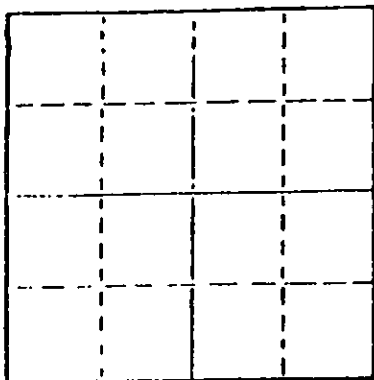

Locate well correctly on above
Section Plat

Ellsworth County, Sec. 36 Twp. 14S Rge. 10W /#W
Location as "NE/CNW/SW" or footage from lines
330' FEL; 1140' FSL of SW/4
Lease Owner Borell Oil Company
Lease Name Ernest Mattas Well No. 1
Office Address Box 158, Wilson, Kansas 67490
Character of Well (Completed as Oil, Gas or Dry Hole) _____
D & A
Date Well completed August 22, 1977
Application for plugging filed August 22, 1977
Application for plugging approved August 22, 1977
Plugging commenced August 22, 1977
Plugging completed August 22, 1977
Reason for abandonment of well or producing formation _____
D & A

If a producing well is abandoned, date of last production 19__

Was permission obtained from the Conservation Division or its agents before plugging was commenced? Yes

Name of Conservation Agent who supervised plugging of this well Gilbert Toman
Producing formation _____ Depth to top _____ Bottom _____ Total Depth of Well 2,820'
Show depth and thickness of all water, oil and gas formations.

OIL, GAS OR WATER RECORDS

CASING RECORD

FORMATION	CONTENT	FROM	TO	SIZE	PUT IN	PULLED OUT
				8 5/8"	207.27'	-0-

Describe in detail the manner in which the well was plugged, indicating where the mud fluid was placed and the method or methods used in introducing it into the hold. If cement or other plugs were used, state the character of same and depth placed, from _____ feet to _____ feet for each plug set.

Plug @ 500' w/40 sx cement
Plug @ 200' w/20 sx cement
Plug @ 40' w/10 sx cement

09-22-77

(If additional description is necessary, use BACK of this sheet)

Name of Plugging Contractor Red Tiger Drilling Company
1720 KSB&T Building, Wichita, Kansas 67202


STATE OF Kansas COUNTY OF Sedgwick, ss. contractor
Gloria Fawcett (employee of ~~XXXXXX~~)
of the above-described well, being first duly sworn on oath, says: That I have knowledge of the facts, statements, and matters herein contained and the log of the above-described well as filed and that the same are true and correct. So help me God.

(Signature) Gloria Fawcett
1720 KSB&T Building, Wichita, Kansas 67202
(Address)

SUBSCRIBED AND SWORN TO before me this 25th day of August, 1977.

Joyce A. Hagermann
Notary Public.

My commission expires _____

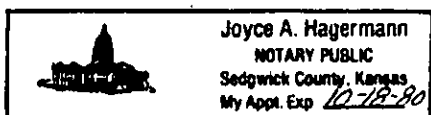

15-053-20482-00-00

DRILLERS LOG

No. 1 Ernest Mattas

CASING RECORD:

COMPANY: Borell Oil Company

DESCRIPTION:

8 5/8" @ 213'
w/125 sx cement

CONTRACTOR: Red Tiger Drilling Company

330' FEL; 1140' FSL of SW/4
Sec. 36-T14S-R10W
Ellsworth County, Kansas

COMMENCED: August 16, 1977

COMPLETED: August 22, 1977

TOTAL DEPTH: 2,820'

ELEVATION: 1,620' GR

<u>FORMATION</u>	<u>FROM</u>	<u>TO</u>	<u>REMARKS</u>
Clay & Shells	0	220	
Clay & Shale	220	410	
Anhydrite	410	434	
Shale	434	1535	
Lime & Shale	1535	1875	
Shale & Lime	1875	2364	
Lime & Shale	2364	2485	
Lime	2485	2820	
RTD		2820	

I certify that this is a true and correct copy of the above log to the best of my knowledge.

RED TIGER DRILLING COMPANY

Gloria Fawcett
Gloria Fawcett

Subscribed and sworn to before me this 25th day of August, 1977.

Joyce A. Hagermann
Notary Public

