


STATE OF KANSAS
STATE CORPORATION COMMISSION

WELL PLUGGING RECORD

Give All Information Completely
Make Required Affidavit
Mail or Deliver Report to
Conservation Division
State Corporation Comm.
245 North Water
Wichita, KS 67202

Ellsworth County. Sec. 35 Twp. 14 Rge. 10 E/W
Location as "NE/CNW 1/4 SW 1/4" or footage from lines
NW NW NW/4

Lease Owner Albert Borrell Oil Co.
Lease Name C. Vanek #1 Well No. _____
Office Address Wilson, Kansas
Character of Well (Completed as Oil, Gas or Dry Hole) _____

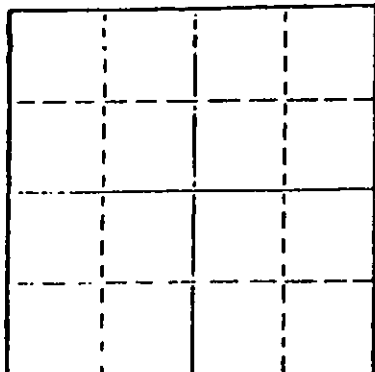

Locate well correctly on above
Section Plot

Date Well completed _____ 19____
Application for plugging filed _____ 19____
Application for plugging approved _____ 19____
Plugging commenced 7/22/77 _____ 19____
Plugging completed 8/15/77 _____ 19____
Reason for abandonment of well or producing formation _____

depleted.
If a producing well is abandoned, date of last production _____ 19____

Was permission obtained from the Conservation Division or
its agents before plugging was commenced? yes

Name of Conservation Agent who supervised plugging of this well Toman
Producing formation _____ Depth to top _____ Bottom _____ Total Depth of Well 2875
Show depth and thickness of all water, oil and gas formations.

OIL, GAS OR WATER RECORDS

CASING RECORD

FORMATION	CONTENT	FROM	TO	SIZE	PUT IN	PULLED OUT
				8-5/8	236	none
				5 1/2"	2873	2020'

Describe in detail the manner in which the well was plugged, indicating where the mud fluid was placed and the method or methods used in introducing it into the hold. If cement or other plugs were used, state the character of same and depth placed, from _____ feet to _____ feet for each plug set.

Sanded to 2850' and ran 5 sacks cement. Shot pipe at 2104', 2015', pulled 66 joints.
Pumped 3 sacks hulls, 20 sacks gel and 85 sacks cement.

PLUGGING COMPLETE.

(If additional description is necessary, use BACK of this sheet)

Name of Plugging Contractor KELSO CASING PULLING
CHASE, KANSAS

STATE OF KANSAS COUNTY OF RICE, ss.
R. DARRELL KELSO (employee of owner) or (owner or operator)
of the above-described well, being first duly sworn on oath, says: That I have knowledge of the facts, statements, and matters herein contained and the log of the above-described well as filed and that the same are true and correct. So help me God.

(Signature) R. Darrell Kelso
CHASE, KANSAS (Address)

SUBSCRIBED AND SWORN TO before me this 16th day of August, 19 77

My commission expires



Margaret Melcher
Notary Public.

KANSAS DRILLERS LOG

*Mailed
1-11-75*

S. 35 T. 14 R. 10 ^E _W


API No. 15 — Ellsworth County — 20376-00-00 Number

Loc. NW NW NW 1/4
Ellsworth

Operator
Borell Oil Co. (Albert W. Borell)

County
640 Acres
N

Address
Wilson, Kansas 67490

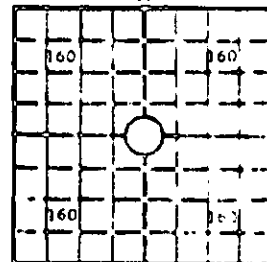

Well No. #1 Lease Name Charles Vanok

Footage Location
foot from (N) (S) line _____ foot from (E) (W) line _____

Principal Contractor Hilson Exploration and Development, Inc., Richard M. Foley Geologist

Spud Date 8/30/74 Total Depth 2875 P.B.T.D.

Elev.: Gr. _____
DF _____ KB 1676

Date Completed 9/9/74 Oil Purchaser

CASING RECORD

Report of all strings set — surface, intermediate, production, etc.

Purpose of string	Size hole drilled	Size casing set (in O.D.)	Weight lbs/ft.	Setting depth	Type cement	Sacks	Type and percent additives
	<u>8 1/2</u>	<u>8 5/8</u>		<u>236</u>	<u>Co</u>	<u>175</u>	
		<u>5 1/2</u>		<u>2873</u>	<u>□</u>	<u>150</u>	<u>60/40</u>

LINER RECORD

PERFORATION RECORD

Top, ft.	Bottom, ft.	Sacks cement	Shots per ft.	Size & type	Depth interval

TUBING RECORD

Size	Setting depth	Packer set at
		<u>RECEIVED</u> <u>STATE CORPORATION COMMISSION</u>

ACID, FRACTURE, SHOT, CEMENT SQUEEZE RECORD

Amount and kind of material used	Depth interval treated
<u>JUL 15 1974</u> <u>CONSERVATION DIVISION</u> <u>Wichita, Kansas</u>	

INITIAL PRODUCTION

Date of first production	Producing method (flowing, pumping, gas lift, etc.)				
RATE OF PRODUCTION PER 24 HOURS	Oil	Gas	Water	Gas-oil ratio	
	bbls.	MCF	bbls.	CFPD	
Disposition of gas (vented, used on lease or sold)			Producing interval(s)		

INSTRUCTIONS: As provided in ICC Rule 82-2-125, within 90 days after completion of a well, one completed copy of this Drillers Log shall be transmitted to the State Geological Survey of Kansas, 4150 Monroe Street, Wichita, Kansas 67209. Copies of this form are available from the Conservation Division, State Corporation Commission, 3830 So. Maridian (P.O. Box 17027), Wichita, Kansas 66217. Phone AC 316-522-2206. If confidential custody is desired, please note Rule 82-2-125. Drillers Logs will be on open file in the Oil and Gas Division, State Geological Survey of Kansas, Lawrence, Kansas 66044.

15-053-20376-00-00

Operator Borell Oil Co. (Albert W. Borell)

DESIGNATE TYPE OF CCMP: OIL, GAS, DRY HOLE, SWD, ETC.

Well No. 1 Lease Name Charles Vanek

oil

S^N 35T 14 R 10W^E

WELL LOG

Show all important zones of porosity and contents thereof; corod intervals, and all drill-stem tests, including depth interval tested, suction used, time tool open, flowing and shut-in pressures, and recoveries.

SHOW GEOLOGICAL MARKERS, LOGS RUN, OR OTHER DESCRIPTIVE INFORMATION.

FORMATION DESCRIPTION, CONTENTS, ETC.	TOP	BOTTOM	NAME	DEPTH
Sappa & Grd Is				46
Dakota form				185
Kowa Form				273
Harper silt				478
Stone Corral (anhydrite tp)				
Hutchinson alt. tp				866
" base				1171
chaso lm tp				1171
Ft. Riley tp				1386
Neva lm tp				1734
Foraker lm tp				1849
Grandhaven tp				2033-357
Tarkio				2111-435
Elmont				2175-499
Howard				2320-644
Topaka				2356-680
Wilson Crk				2398-722
Heebner				2650-974
Toronto				2668-992
Douglas				2682-1006
Brown Lm				2749-1073
Lansing				2770-1094
Dist #1 2370-2408 Odor, Mis run 70' off				
Dist #2 2792-2810 Op-3hrs (30-60-50-60) Rec'd gas to surface 38 min; 500' gassy oil 60" Sip-953-817 Fp 39-48-58-166				
Dist #3 2845-2875 Op 90 min fair blow recover 120' slight oil sp 30 sip-1011-1011 fp-19-39, 39-48				

RECEIVED
STATE COMMISSION OF CONSERVATION
JUL 15 1975
CONSERVATION DIVISION
Topeka, Kansas

USE ADDITIONAL SHEETS, IF NECESSARY, TO COMPLETE WELL RECORD.

Date Received

Julius Ehrlich
Pres.

Signature

Title

January 7, 1975

Date