

STATE OF KANSAS  
STATE CORPORATION COMMISSION


WELL PLUGGING RECORD

Give All Information Completely  
Make Required Affidavit  
Mail or Deliver Report to  
Conservation Division  
State Corporation Comm.  
245 North Water  
Wichita, KS 67202

Ellsworth County. Sec. 35 Twp. 14S Rge. 10 N/W  
Location as "NE/CNW/SW" or footage from lines  
NE SW NW

Lease Owner Borell Oil Co.  
Lease Name Vanek Well No. 4

Office Address Box 391, Wilson, Kansas  
Character of Well (Completed as Oil, Gas or Dry Hole) D & A

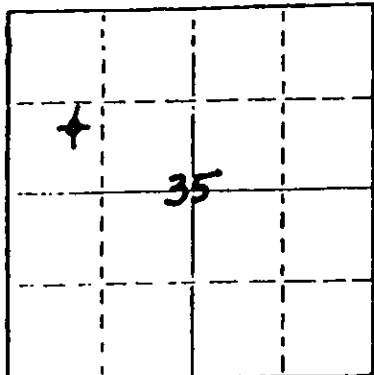

Locate well correctly on above  
Section Plot

Date Well completed August 23, 19 76  
Application for plugging filed August 23, 19 76  
Application for plugging approved August 23, 19 76  
Plugging commenced August 23, 19 76  
Plugging completed August 23, 19 76  
Reason for abandonment of well or producing formation D & A

If a producing well is abandoned, date of last production 19 76

Was permission obtained from the Conservation Division or its agents before plugging was commenced? Yes

Name of Conservation Agent who supervised plugging of this well Gilbert Toman  
Producing formation \_\_\_\_\_ Depth to top \_\_\_\_\_ Bottom \_\_\_\_\_ Total Depth of Well 2852  
Show depth and thickness of all water, oil and gas formations.

OIL, GAS OR WATER RECORDS

CASING RECORD

FORMATION	CONTENT	FROM	TO	SIZE	PUT IN	PULLED OUT
				8-5/8	227	-0-

Describe in detail the manner in which the well was plugged, indicating where the mud fluid was placed and the method or methods used in introducing it into the hold. If cement or other plugs were used, state the character of same and depth placed, from \_\_\_\_\_ feet to \_\_\_\_\_ feet for each plug set.

Mud to 500' w/40 sx cement  
Mud to 220' w/25 sx cement  
Mud to 40' w/1/2 sx HULLS RECEIVED  
Plug w/10 sx STATE CORPORATION COMMISSION  
2 sx in rathole

AUG 31 1976

CONSERVATION DIVISION  
Wichita, Kansas

(If additional description is necessary, use BACK of this sheet)

Name of Plugging Contractor Red Tiger Drilling Company


STATE OF Kansas COUNTY OF Sedgwick, ss.  
Joyce A. Hagermann (employee of owner) or (~~owner~~)  
of the above-described well, being first duly sworn on oath, says: That I have knowledge of the facts, statements, and matters herein contained and the log of the above-described well as filed and that the same are true and correct. So help me God.

(Signature) Joyce A. Hagermann  
1720 Kansas State Bank Bldg.  
(Address)

SUBSCRIBED AND SWORN TO before me this 26th day of August, 1976

Jean Stracks  
Notary Public.

My commission expires 7-12-80

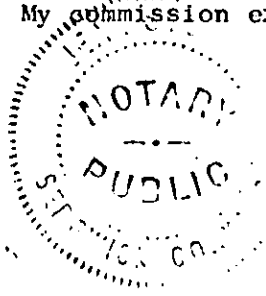

15-053-20449-06-00

DRILLERS LOG

#4 Vanek

CASING RECORD:

8-5/8" @ 220  
w/135 sx cmt.

TOTAL DEPTH:

2852

COMPANY: Borell Oil Co.

CONTRACTOR: Red Tiger Drilling Co.

COMMENCED: August 17, 1976

COMPLETED: August 23, 1976

DESCRIPTION:

NE SE NW  
Sec. 35-14S-10W  
Ellsworth County,  
Kansas

ELEVATION:

FORMATION

FROM

TO

REMARKS

Surface Soil & Sand	0	80
Clay & Shales	80	227
Blue Shale	227	807
Shale	807	1435
Lime	1435	2030
Shale & Lime	2030	2250
Lime	2250	2852
RTD		2852

RECEIVED  
STATE COMMISSIONER OF GEOL.

AUG 31 1976

CONSERVATION DIVISION  
STATE OF KANSAS

I certify that this is a true and correct copy of the above log to the best of my knowledge.

RED TIGER DRILLING COMPANY

*Joyce A. Hagermann*  
Joyce A. Hagermann

Subscribed and sworn to before me this 26th day of August, 1976.

*Juan Stacks*  
Notary Public

My Commission Expires: 7/12/80

