

STATE OF KANSAS  
STATE CORPORATION COMMISSION


WELL PLUGGING RECORD

Give All Information Completely  
Make Required Affidavit  
Mail or Deliver Report to:  
Conservation Division  
State Corporation Commission  
800 Bitting Building  
Wichita, Kansas

11<sup>th</sup> North County, Sec. 28 Twp. 14 Rge. 10 (E) (W)

Location as "NE/CNW $\frac{1}{4}$ SW $\frac{1}{4}$ " or footage from lines  
Lease Owner  
Lease Name  
Office Address  
Character of Well (completed as Oil, Gas or Dry Hole)  
Date well completed  
Application for plugging filed  
Application for plugging approved  
Plugging commenced  
Plugging completed  
Reason for abandonment of well or producing formation

NORTH

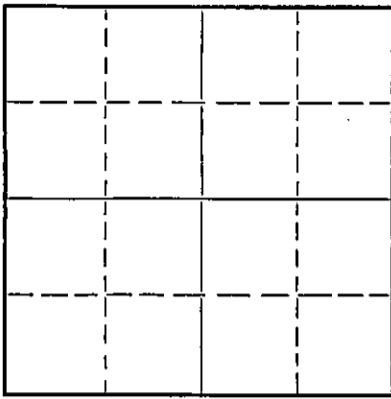

Locate well correctly on above  
Section Plat

If a producing well is abandoned, date of last production  
Was permission obtained from the Conservation Division or its agents before plugging was commenced?

Name of Conservation Agent who supervised plugging of this well  
Producing formation  
Depth to top  
Bottom  
Total Depth of Well  
Show depth and thickness of all water, oil and gas formations.

OIL, GAS OR WATER RECORDS

CASING RECORD

Table with 7 columns: Formation, Content, From, To, Size, Put In, Pulled Out. Row 1: From 0 To 286' Size 8 5/8" Put In 286' Pulled Out None

Describe in detail the manner in which the well was plugged, indicating where the mud fluid was placed and the method or methods used in introducing it into the hole. If cement or other plugs were used, state the character of same and depth placed, from feet to feet for each plug set.

From 3300' to 276' - heavy rotary mud  
From 276' to 275' - wooden plug  
From 275' to 229' - 15 sacks cement  
From 229' to 218' - heavy rotary mud  
From 218' to 20' - wooden plug  
From 20' to 6' - 5 sacks cement  
From 6' to surface to cellar

10-15-51

(If additional description is necessary, use BACK of this sheet)

Correspondence regarding this well should be addressed to  
Address

STATE OF KANSAS, COUNTY OF BUTLER, SS.

(employee of owner) or (owner or operator) of the above-described well, being first duly sworn on oath, says: That I have knowledge of the facts, statements, and matters herein contained and the log of the above-described well as filed and that the same are true and correct. So help me God.

(Signature)

W. C. Box 28, Wellington, Kansas

(Address)

SUBSCRIBED AND SWORN to before me this 9th day of October, 1951

Notary Public

My commission expires

April 23, 1955

PLUGGING  
FILE SEC 28 T 14 R 10  
BOOK PAGE 115 LINE 30

D R I L L E R ' S

L O G

Company: W. H. Peole

SE-NE-NW

Farm: Epton Well No. 1  
Total Depth: 3300'

Sec. 28, Twp. 14, Rge. 10

County: Ellsworth, Kansas

Comm: 9-27-31 Comp: 10-3-31

Contractor: Peol Brothers, Inc.

Elevation:

Casing: 286' 3 5/8" con.

Production: Dry

Figures below indicate bottom of formations

|                             |    |      |
|-----------------------------|----|------|
| Sand                        | 0' | 30   |
| Shale                       |    | 60   |
| Sand                        |    | 85   |
| Shale                       |    | 165  |
| Shale-Sand Streaks & Pyrite |    | 286  |
| Shale and Sand              |    | 140  |
| Shale                       |    | 400  |
| Shale & Red Bed             |    | 475  |
| Anhydrite                   |    | 505  |
| Sand, Shale & Shells        |    | 525  |
| Shale                       |    | 1165 |
| Shale & Lime                |    | 1535 |
| Lime                        |    | 1610 |
| Lime & Shale                |    | 2865 |
| Lime                        |    | 3175 |
| Lime & Shale                |    | 3225 |
| Lime                        |    | 3275 |
| Arbuckle                    |    | 3300 |
| Total Depth                 |    | 3300 |

This is to certify that the above information is, to the best of our knowledge true and correct.

PEOL BROTHERS, INC.,

STATE OF KANSAS  
REGULATORY COMMISSION  
OCT 10 1931

BY: Robert L. Sutton

SUBSCRIBED AND SWORN to before me this 9 day of October, 1931.

Bernice L. Jensen  
Notary Public

My commission expires: APRIL 23, 1932.

PLUGGING  
FILE SEC 28 T 14 R 10 NW  
BOOK PAGE 115 LINE 32