


WELL PLUGGING RECORD

Give All Information Completely
Make Required Affidavit
Mail or Deliver Report to:
Conservation Division
State Corporation Commission
800 Bitting Building
Wichita, Kansas

NORTH

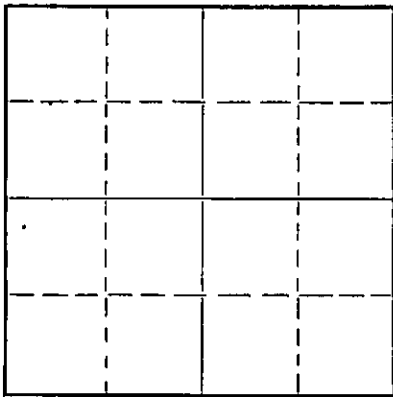

Locate well correctly on above
Section Plat

ELLIS County. Sec. 24 Twp. 14S Rge. 16W (E) (W)
Location as "NE/CNW $\frac{1}{4}$ SW $\frac{1}{4}$ " or footage from lines NW NW NW
Lease Owner R. W. RINE DRILLING CO. - BUFFALO OIL COMPANY
Lease Name DORTLAND # 1 Well No. 1
Office Address 320 CENTRAL BUILDING, WICHITA, KANSAS
Character of Well (completed as Oil, Gas or Dry Hole) DRY HOLE
Date well completed 9-28 1951
Application for plugging filed 9-28 1951
Application for plugging approved 9-28 1951
Plugging commenced 9-28 1951
Plugging completed 9-28 1951
Reason for abandonment of well or producing formation DRY

If a producing well is abandoned, date of last production NONE 19
Was permission obtained from the Conservation Division or its agents before plugging was commenced? YES

Name of Conservation Agent who supervised plugging of this well ELDON PETTY, BOX 326, HAYS, KANSAS
Producing formation Depth to top Bottom Total Depth of Well Feet
Show depth and thickness of all water, oil and gas formations.

OIL, GAS OR WATER RECORDS

CASING RECORD

Formation	Content	From	To	Size	Put In	Pulled Out
WATER SAND	WATER	150	135	8-5/8	253'	CEMENTED

Describe in detail the manner in which the well was plugged, indicating where the mud fluid was placed and the method or methods used in introducing it into the hole. If cement or other plugs were used, state the character of same and depth placed, from feet to feet for each plug set.

HEAVY MUD FROM TOTAL DEPTH - 240' PLUG AT 240' w/15 SACKS CEMENT

HEAVY MUD FROM 240' TO 40' PLUG AT 40' w/10 SACKS CEMENT

10-08-1951

(If additional description is necessary, use BACK of this sheet)
Correspondence regarding this well should be addressed to R. W. RINE DRILLING COMPANY
Address 320 CENTRAL BUILDING, WICHITA, KANSAS

STATE OF KANSAS, COUNTY OF SEDGWICK, ss.
EMPLOYEE OF OWNER (employee of owner) or (owner or operator) of the above-described well,
being first duly sworn on oath, says: That I have knowledge of the facts, statements, and matters herein contained and the log of the above-described well as filed and that the same are true and correct. So help me God.

(Signature) *Am Green*
320 Central Bldg Wichita, Ks (Address)

SUBSCRIBED AND SWORN TO before me this 5th day of October, 1951

Leonal Pedersen
Notary Public.

My commission expires April 20, 1955

FILE SEC. 29 T. 14 R. 16 W
BOOK PAGE 16 LINE 7

15-051-00637-00-00

NW NW NW
SEC. 24-14S-16W
ELLIS COUNTY, KANSAS

DORTLAND WELL No. 1

CONTRACTOR: THE R. W. RINE DRILLING COMPANY
STARTED: SEPTEMBER 15, 1951

FINISHED: SEPTEMBER 28, 1951

LOG

SURFACE ROCK AND SAND	0 - 355	8-5/8" Csg. @ 253' w/225 Sx.
LINE, SHALE AND SAND	355 - 380	SYFO @ 250' - OK
LINE, SHALE, SAND AND SHELLS	380 - 642	
RED BED, SHALE, SHELLS	642 - 1130	SYFO @ 1000' - OK
SHALE AND SHELLS	1130 - 1700	SYFO @ 1500' - 1/2"
LINE AND SHALE	1700 - 1890	
SHALE AND LINE	1890 - 2015	SYFO @ 2000' - OK
LINE, SHALE	2015 - 2420	
SHALE AND LINE	2420 - 2605	SYFO @ 2500' - OK
LINE	2605 - 2750	
LINE AND SHALE	2750 - 2815	
LINE	2815 - 2890	
LINE AND SHALE	2890 - 2950	
LINE	2950 - 3130	SYFO @ 3000' - OK
LINE	3130 - 3205	
LINE	3205 - 3305	
LINE	3305 - 3405	
CONG.	3405 - 3441	
ARBUCKLE	3441 - 3447	
LINE	3447 - 3480	T.D. - D & A 1 PLUG 240' w/15 Sx. 2 PLUG 40' w/10 Sx.

STATE OF KANSAS }
COUNTY OF SEDGWICK } ss.

I, R. M. GREEN, DO HEREBY CERTIFY THAT THE ABOVE IS A TRUE AND ACCURATE LOG OF THE DORTLAND WELL No. 1, LOCATED NW NW NW, SEC. 24-14S-16W, ELLIS COUNTY, KANSAS.

R. M. Green
ASSISTANT SECRETARY

SUBSCRIBED TO AND SWORN BEFORE ME THIS 24TH DAY OF OCTOBER, 1951.

Leonard Pederson
NOTARY PUBLIC

MY COMMISSION EXPIRES APRIL 20, 1955

FILE SEC 24 T 14 R 16 W
BOOK PAGE 113 LINE 7

RECORDED
NOV - 6 1951
Wichita, Kansas
11-06-1951