

STATE OF KANSAS  
STATE CORPORATION COMMISSION

WELL PLUGGING RECORD

Give All Information Completely  
Make Required Affidavit  
Mail or Deliver Report to  
Conservation Division  
State Corporation Comm.  
245 North Water  
Wichita, KS 67202

Scott County, Sec. 10 Twp. 16S Rge. 31 E/W  
Location as "NE/CNW $\frac{1}{2}$ SW $\frac{1}{2}$ " or footage from lines

C NE NW

Lease Owner H. A. Chapman Investments  
Lease Name Harper Well No. #1  
Office Address 404 Cities Service Bldg., Tulsa, Okla. 74119  
Character of Well (Completed as Oil, Gas or Dry Hole)

Dry Hole


Date Well completed 1-4-77 19  
Application for plugging filed 1-4-77 19  
Application for plugging approved 1-4-77 19  
Plugging commenced 1-4-77 19  
Plugging completed 1-4-77 19

Reason for abandonment of well or producing formation  
Commercial quantities of oil not found.

If a producing well is abandoned, date of last production 19

Was permission obtained from the Conservation Division or its agents before plugging was commenced? Yes

Name of Conservation Agent who supervised plugging of this well Gilbert Balthazor, Palco, Ks.  
Producing formation Depth to top Bottom Total Depth of Well 4640'  
Show depth and thickness of all water, oil and gas formations.

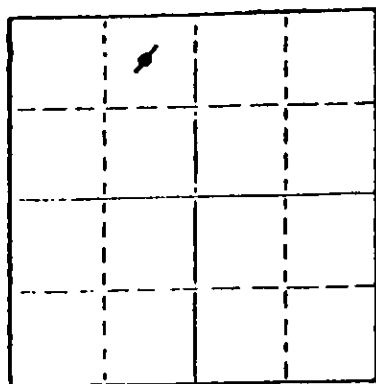

Locate well correctly on above Section Plat

OIL, GAS OR WATER RECORDS

CASING RECORD

FORMATION	CONTENT	FROM	TO	SIZE	PUT IN	PULLED OUT
				8 5/8"	358'	None

Describe in detail the manner in which the well was plugged, indicating where the mud fluid was placed and the method or methods used in introducing it into the hold. If cement or other plugs were used, state the character of same and depth placed, from feet to feet for each plug set.

RECEIVED  
STATE CORPORATION COMMISSION  
JAN 12 1977  
1-12-77  
CONSERVATION DIVISION  
Wichita, Kansas

Plug @ 950' w/70 sx.  
Plug @ 300' w/20 sx.  
Plug @ 40' w/10 sx.

(If additional description is necessary, use BACK of this sheet)

Name of Plugging Contractor Rains & Williamson Oil Co., Inc.

STATE OF Kansas COUNTY OF Sedgwick, ss.

Wilson Rains, President of Rains & Williamson Oil Co., Inc. (employee of owner) or (owner or operator) of the above-described well, being first duly sworn on oath, says: That I have knowledge of the facts, statements, and matters herein contained and the log of the above-described well as filed and that the same are true and correct. So help me God.


(Signature)

Wilson Rains  
435 Page Court, 220 W. Douglas, Wichita, Kansas  
(Address)

SUBSCRIBED AND SWORN TO before me this 6 day of January, 1977

Juanita M. Green Notary Public.

My commission expires 10-4-79

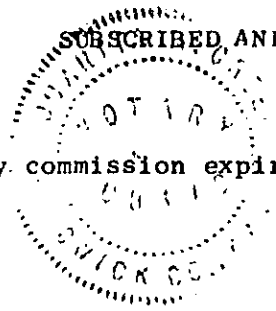

DRILLER'S LOG

COMPANY: H. A. Chapman Investments

SEC. 10 T. 16S R. 31W

WELL NAME: Harper #1

LOC. C NE NW

COUNTY: Scott

RIG NO. #7

TOTAL DEPTH 4640'

ELEVATION

COMMENCED: 12-18-76 COMPLETED: 1-4-77

CONTRACTOR: Rains & Williamson Oil Co., Inc.

CASING RECORD:

SURFACE: 8 5/8" @ 358' w/250 sx. 60/40 poz., 2% gel and 3% cc.

PRODUCTION: D&A

RECEIVED  
JAN 7 1977  
H. A. C. INV.

LOG

(Figures Indicate Bottom of Formations)

Shale & Sand	355
Shale	1320
Shale & Clay	1814
Shale	1920
Sand	2070
Shale	2582
Shale & Lime	2925
Shale w/Lime	3057
Shale & Lime	3440
Lime & Shale	3581
Lime	3590
Lime & Shale	3775
Lime	3847
Lime w/Shale	3936
Lime	4640
<u>ROTARY TOTAL DEPTH</u>	<u>4640</u>

RECEIVED  
STATE OF KANSAS  
JAN 12 1977  
GEOLOGICAL DIVISION  
Wichita, Kansas

STATE OF Kansas )  
COUNTY OF Sedwick ) SS:

I, Wilson Rains, President of Rains & Williamson Oil Co., Inc.  
upon oath state that the above and foregoing is a true and correct copy of the log of the  
Harper #1 well.

Wilson Rains  
Wilson Rains



Subscribed and sworn to before me this 6 day of January, 1977.

My Appointment Expires:  
10-4-79

Juanita M. Green  
Juanita M. Green