


WELL PLUGGING RECORD

Give All Information Completely  
Make Required Affidavit  
Mail or Deliver Report to:  
Conservation Division  
State Corporation Commission  
211 No. Broadway  
Wichita, Kansas

Scott County. Sec. 25 Twp. 16S Rge. 34Wxxx (W)  
Location as "NE/CNW&SW" or footage from lines C NW SW  
Lease Owner D. R. Lauck Oil Company, Inc.  
Lease Name Carson Well No 1  
Office Address 301 S. Broadway, Wichita, Kansas  
Character of Well (completed as Oil, Gas or Dry Hole) Dry Hole  
Date well completed December 8, 19 65  
Application for plugging filed December 8, 19 65  
Application for plugging approved December 8, 19 65  
Plugging commenced December 8, 19 65  
Plugging completed December 8, 19 65  
Reason for abandonment of well or producing formation Dry Hole

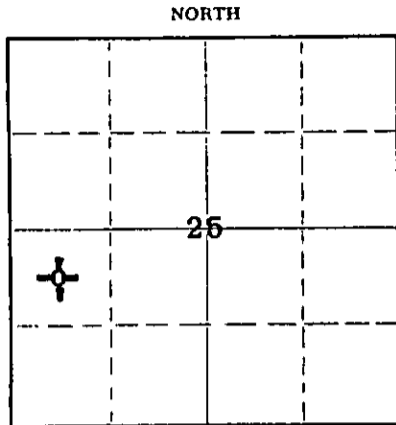

Locate well correctly on above  
Section Plat

If a producing well is abandoned, date of last production \_\_\_\_\_ 19\_\_\_\_  
Was permission obtained from the Conservation Division or its agents before plugging was commenced? Yes

Name of Conservation Agent who supervised plugging of this well W. L. Nichols  
Producing formation \_\_\_\_\_ Depth to top \_\_\_\_\_ Bottom \_\_\_\_\_ Total Depth of Well 4820 Feet  
Show depth and thickness of all water, oil and gas formations.

OIL, GAS OR WATER RECORDS

CASING RECORD

FORMATION	CONTENT	FROM	TO	SIZE	PUT IN	PULLED OUT
		0'	238'	8-5/8"	238'	None

Describe in detail the manner in which the well was plugged, indicating where the mud fluid was placed and the method or methods used in introducing it into the hole. If cement or other plugs were used, state the character of same and depth placed, from \_\_\_\_\_ feet to \_\_\_\_\_ feet for each plug set.

4820'-660' Mud  
660'-656' Plug  
656'-616' Cement, 20 sacks  
616'-240' Mud  
240'-236' Plug  
236'-196' Cement, 20 sacks  
196'- 40' Mud  
40'- 36' Plug  
36'- 6' Cement, 10 sacks (Bottom of cellar)

DEC 16 1965  
12-16-65

(If additional description is necessary, use BACK of this sheet)  
Name of Plugging Contractor Lauck Drilling Company, Incorporated  
Address 301 S. Broadway, Wichita, Kansas

STATE OF KANSAS, COUNTY OF SEDGWICK, ss.  
John H. Knightley (employee of owner) or (owner or operator) of the above-described well, being first duly sworn on oath, says: That I have knowledge of the facts, statements, and matters herein contained and the log of the above-described well as filed and that the same are true and correct. So help me God.  
(Signature) John H. Knightley  
301 S. Broadway, Wichita, Kansas  
(Address)

SUBSCRIBED AND SWORN TO before me this 14th day of December, 19 65  
Stella J. Lippie  
Notary Public.

My commission expires March 12, 1967

15-171-30057-0000

D. R. Lauck Oil Company, Inc.

Carson #1

C NW SW 25-16S-34W  
Scott County, Kansas

Commenced: 11-24-65  
Completed: 12-8-65

DEC 16 1965

Casing Record: 238' 8-5/8" Cemented with 175 sacks Cement,  
4 sacks Calcium Chloride.

Elevation: GL 3102; DF 3105; KB 3107.

Drillers Log

Tops

Drillers Log		Samples	Welex
Surface Soil & Shale	50		
Sand	70		
Shale	120		
Sand	205		
Shale	1050	Anhydrite	2420+687
Shale & Shell	1250	Topeka	3701-594
Sand & Shale	1394	Heebner	3970-863
Anhydrite Streaks,		Toronto	3987-880
Shale & Shell	1445	Lansing	4011-904
Sand & Shale Streaks	1545	B. Kansas City	4400-1293
Shale & Red Bed	1680	Marmaton	4434-1327
Red Bed, Shale & Anhy.	2050	Ft. Scott	4556-1449
Shale & Shells	2325	Cherokee Shale	4563-1456
Shale & Lime	2570	Morrow Shale	4708-1601
Shale & Shells	2635	Mississippian	4758-1651
Shale & Lime	3082	Ste. Genevieve	4758-1651
Broken Lime & Shale	3240	St. Louis ?	4784-1677
Shale & Lime	3330	Total Depth	4820-1713
Lime & Shale	3390		4823-1716
Chert	3398		
Lime & Shale	3538		
? Shale & Lime	3630		
Shale & Lime	3700		
Lime	3735		
Shale & Lime	3928		
Lime	3962		
Heebner Shale	3967		
Limes	4022		
Lime	4100		
Shale & Lime	4159		
Lime	4398		
Shale & Lime	4460		
Lime	4820		

D&A

Certified by:

*John H. Knightley*  
John H. Knightley, Secretary