

WELL PLUGGING RECORD

Give All Information Completely
Make Required Affidavit
Mail or Deliver Report to:
Conservation Division
State Corporation Commission
800 Bittling Building
Wichita, Kansas

Scott County. Sec. 28 Twp. 16S Rge. 33 (X) (W)

Location as "NE/CNW $\frac{1}{4}$ /SW $\frac{1}{4}$ " or footage from lines NW $\frac{1}{4}$ NE $\frac{1}{4}$ NW $\frac{1}{4}$

Lease Owner Hugoton Production Company

Lease Name Dirks Well No. 1

Office Address. Box 441, Garden City, Kansas

Character of Well (completed as Oil, Gas or Dry Hole) Dry Hole

Date well completed. February 2 19 53

Application for plugging filed. February 4 19 53

Application for plugging approved. February 2 (by Phone) 19 53


Plugging commenced. February 2 19 53

Plugging completed. February 2 19 53

Reason for abandonment of well or producing formation. Dry hole

If a producing well is abandoned, date of last production 19

Was permission obtained from the Conservation Division or its agents before plugging was commenced? yes (by Phone)

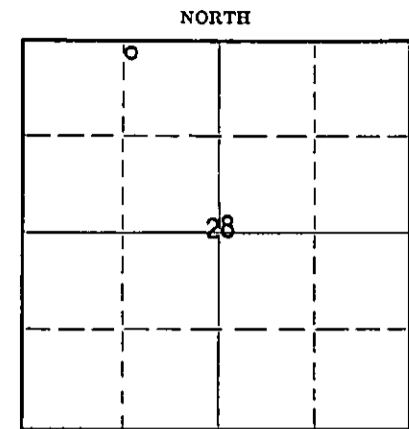

Name of Conservation Agent who supervised plugging of this well. Mr. Stough, Great Bend, Ks. (by Phone)

Producing formation. none Depth to top. Bottom. Total Depth of Well. 5202 Feet

Show depth and thickness of all water, oil and gas formations.

OIL, GAS OR WATER RECORDS

CASING RECORD

Formation	Content	From	To	Size	Put In	Pulled Out
				8 5/8"	289'	

Describe in detail the manner in which the well was plugged, indicating where the mud fluid was placed and the method or methods used in introducing it into the hole. If cement or other plugs were used, state the character of same and depth placed, from...feet to...feet for each plug set.

Set Halliburton 8 5/8" rubber plug @ 280' Dumped 20 sacks cement on top plug. Run 2nd Halliburton 8 5/8" rubber plug @ 35' and run 10 sacks cement on top of this plug. Contractor put cottonseed hulls on top & bottom of each plug.

(If additional description is necessary, use BACK of this sheet)


Correspondence regarding this well should be addressed to John L. James
Address. Box 441, Garden City, Kansas

STATE OF Kansas, COUNTY OF Finney, ss.
Jack L. Yinger (employee of owner) or (owner or operator) of the above-described well, being first duly sworn on oath, says: That I have knowledge of the facts, statements, and matters herein contained and the log of the above-described well as filed and that the same are true and correct. So help me God.

(Signature) Jack L Yinger
Box 441, Garden City, Kansas (Address)

SUBSCRIBED AND SWORN to before me this 4th day of February, 19 53
Notary Public.

My commission expires January 30, 1954 22-7877-5 4-40-10M

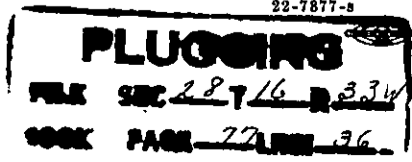

2-5-53

HUGOTON PRODUCTION COMPANY
Box 441
Garden City, Kansas

Company: HUGOTON PRODUCTION CO.
Farm: Dirks No. 1

Sec. 28 T. 16S R. 33W
NW NE NW

Total Depth. 5202
Comm. 1-4-53 Comp. 2-2-53
Shot or treated.
Contractor. Glenn R. Nye Drlg. Co.
Issued.

County Scott
Kansas

Elevation. 3074.55 G.L.
3079.55 K.E.

CASING:
8 3/4" 289' cem. w/250 sx

Figures Indicate Bottom of Formations

sand & gravel	0-200	lime & shale	3348
blue shale	299	cherty lime & shale	3356
shale	1040	shale & lime	3555
shale & sand	1500	shale	3610
shale & shells	1695	lime w/very little shale	4300
anhydrite	1730	lime	4430
shale & shells	2215	lime & shale	4495
red bed shale & gyp	2412	lime	4545
anhydrite	2442	lime & shale	4692
shale & shells	2465	lime, shale & chert	4734
shale	2675	sand	4740
red bed, chalk	2815	conglomerate	4742
lime, red bed, chalk	2835	sand	4754
shale	2960	lime	4812
lime & shale	3017	lime & shale	4930
shale	3080	cherty lime & shale	4968
lime & shale	3208	lime	5100
shale	3228	chert & lime	5202

DST No. 1 4505-4576
Tool open 1 HR
F.F.P. -0
B.H.P. -690
Rec. 33' gas cut mud


DST No. 2 4667-4690
Tool open 1 HR
F.F.P. -0
B.H.P. -0
Rec. 20' Drlg. mud

Heebner 3982'
Lans-K.C. 4025'
Miss. 4743'
(all measurements from K.E.)

Core No. 1 4734-4761
Core No. 2 4761-4811
Core No. 3 5180-5183
Core No. 4 5183-5202

No electric log was run on this well.

Loss circulation at 5202' after which well was abandoned.

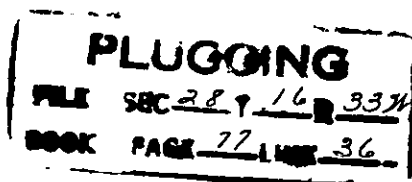

ST.

ST.