

STATE CORPORATION COMMISSION OF KANSAS
OIL & GAS CONSERVATION DIVISION
WELL COMPLETION FORM
ACO-1 WELL HISTORY
DESCRIPTION OF WELL AND LEASE

Operator: License # 5684Name: George SageAddress: Box 2City/State/Zip Virgil KS 66870

Purchaser: _____

Operator Contact Persons: SamePhone (316) 678 3440

Contractor: Name: _____

License: _____

Wellsite Geologist: _____

Designate Type of Completion

☒ New Well ☐ Re-Entry ☐ Workover☒ Oil ☐ SWD ☐ Temp. Abd.☐ Gas ☐ Inj ☐ Delayed Comp.☐ Dry ☐ Other (Core, Water Supply, etc.)

If OWS: old well info as follows:

Operator: _____

Well Name: _____

Comp. Date _____ Old Total Depth _____

Drilling Method:

☒ Mud Rotary ☐ Air Rotary ☐ Cable

Spud Date _____

Date Reached TD _____

Completion Date 2-21-81

INSTRUCTIONS: This form shall be completed in triplicate and filed with the Kansas Corporation Commission, 200 Colorado Derby Building, Wichita, Kansas 67202, within 120 days of the spud date of any well. Rule 82-3-106 apply. Information on side two of this form will be held confidential for a period of 12 months if requested in writing and submitted with the form. See rule 82-3-107 for confidentiality in excess of 12 months. One copy of all wireline logs and drillers time log shall be attached with this form. ALL CEMENTING TICKETS MUST BE ATTACHED. Submit CP-4 form with all plugged wells. Submit CP-111 form with all temporarily abandoned wells. Any recompletion, workover or conversion of a well requires filing of ACO-2 within 120 days from commencement date of such work.

All requirements of the statutes, rules and regulations promulgated to regulate the oil and gas industry have been fully complied with and the statements herein are complete and correct to the best of my knowledge.

Signature: George SageTitle: Owner Date: 5-1-91Subscribed and sworn to before me this 1 day of MayNotary Public: Kelly SageNotary Commission Expires: 4-24-93API NO. 15- 15-207-22573-00-00County: WoodsonSec. 28 Twp. 25 Rgo. 15 East West4950 Ft. North from Southeast Corner of Section330 Ft. West from Southeast Corner of Section

(NOTE: Locate well in section plat below.)

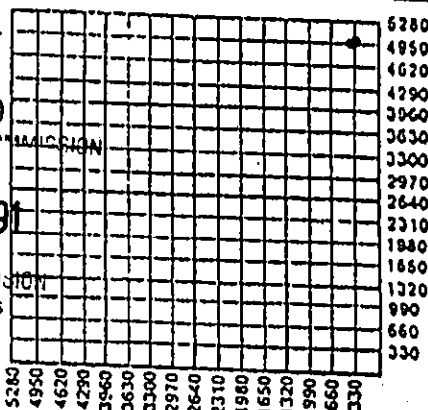
Lease Name Degree of Honor Well # 116Field Name Yates CenterProducing Formation Miss

Elevation: Ground _____ KB _____

Total Depth 1538 PBTD _____

RECEIVED

JUL 19 1991

CONSERVATION DIVISION
Wichita, KansasAmount of Surface Pipe Set and Cemented at 44 FeetMultiple Stage Cementing Collar Used? ☐ Yes ☐ No

If yes, show depth set _____ Feet

If Alternate II completion, cement circulated from _____

feet depth to _____ w/ _____ in. cement.

Signature: George SageTitle: Owner Date: 5-1-91Subscribed and sworn to before me this 1 day of MayNotary Public: Kelly SageNotary Commission Expires: 4-24-93

K.C.C. OFFICE USE ONLY

F ☐ Letter of Confidentiality Attached
C ☐ Wireline Log Received
C ☐ Drillers Timelog Received

Distribution
☒ KCC ☐ SWD/Rep ☐ NGPA
☐ KGS ☐ Plug ☐ Other
(Specify)

Form ACO-1 (7-89)



KELLY SAGE
NOTARY PUBLIC
STATE OF KANSAS
MY APPT. EXPIRES

Operator Name

Lease Name

sec. 28 Twp. 25 Rgo. 15

County Wob

Drill Stem Tests Taken
(Attach Additional Shoots.)

Samples Sent to Geological Survey

Cores Taken

Electric Log Run
(Submit Copy.)

☐ Yes ☐ No

☐ Yes ☐ No

☐ Yes ☐ No

☐ Yes ☐ No

Formation Description

☐ Log ☐ Sample

None

[↑ Top](#)

Bottom

☐ New ☐ Used

☐ New ☐ Used
Report all strings set-conductor, surface, intermediate, production; etc.

Date of First Production	Producing Method ☐ Flowing ☐ Pumping ☐ Gas Lift ☐ Other (Explain)				
Estimated Production Per 24 Hours	Oil Bbls.	Gas Mcf	Water Bbls.	Gas-Oil Ratio	Gravity

Disposition of Gas:

METHOD OF COMPLETION

Production Interval

☐ Vented ☐ Sold ☐ Used on Lease
(If vented, submit ACO-18.)

☐ Open Hole ☐ Perforation ☐ Dually Completed ☐ Commingled
☐ Other (Specify) _____