

STATE OF KANSAS
STATE CORPORATION COMMISSION
200 Colorado Derby Building
Wichita, Kansas 67202

WELL PLUGGING RECORD
K.A.R.-82-3-117

API NUMBER 15-19920123-00-00

LEASE NAME McKinney 34-13

WELL NUMBER #1

660 Ft. from S Section Line

1605 Ft. from E Section Line

SEC. 13 TWP. 14 RGE. 43 ~~08~~ (W)

COUNTY Wallace

Date Well Completed 12-7-87

Plugging Commenced 12-8-87

Plugging Completed 12-8-87

TYPE OR PRINT
NOTICE: Fill out completely
and return to Cons. Div.
office within 30 days.

LEASE OPERATOR Union Pacific Resources Company

ADDRESS P. O. Box 1257 Englewood, CO. 80150

PHONE # (303) 721-2591 OPERATORS LICENSE NO. 6417

Character of Well D&A

(Oil, Gas, D&A, SWD, Input, Water Supply Well)

The plugging proposal was approved on 12-3-87 (date)

by Gilbert Baltzore (KCC District Agent's Name).

Is ACO-1 filed? yes If not, is well log attached? _____

Objective Morrow Sand Morrow sand not present
Formation Morrow Sand Depth to Top _____ Bottom T.D. 5350'

Show depth and thickness of all water, oil and gas formations.

OIL, GAS OR WATER RECORDS

CASING RECORD

Formation	Content	From	To	Size	Put In	Pulled out
Surface	Sand - shale	0	705	8-5/8"	705'	-0-
Shawnee	Porous Zone	4005	4041	N/A		
Shawnee	Porous Zone	4087	4098	N/A		
Shawnee	Porous Zone	4156	4171	N/A		

Describe in detail the manner in which the well was plugged, indicating where the mud fluid was placed and the method or methods used in introducing it into the hole. If cement or other plugs were used, state the character of same and depth placed, from ___ feet to ___ feet each set.

Spotted 25 sxs of 60-40 POZ w/6% gel, 3% CaCl2; 1/4#/sx Celloflake @ 2860'; spotted 100 sxs @ 1960'; spotted 40 sxs @ 750'; spotted 10 sxs @ 40' w/wiper plug; spotted 15 sxs in rathole; 10 sxs on mousehole; Well plugged & abandoned on December 8, 1987
(If additional description is necessary, use BACK of this form.)

Name of Plugging Contractor Halliburton Services License No. _____

Address Colorado Derby Boulding - Suite 600 - Wichita, Kansas 67202-1203

STATE OF Colorado COUNTY OF Arapahoe, ss.

Joy L. Daniel (Employee of Operator) or (Operator) of above-described well, being first duly sworn on oath, says: That I have knowledge of the facts, statements, and matters herein contained and the log of the above-described well as filed that the same are true and correct, so help me God.

(Signature) Joy L. Daniel
Union Pacific Resources Company

(Address) P. O. Box 1257 - Englewood, CO 80150

STAT. CO. 02-16-88

SUBSCRIBED AND SWORN TO before me this 3rd day of February, 1988

Mary G. Bergmann
Notary Public

My Commission Expires: 8-5-90




Holloway & Holloway, Inc.
 4218 W. 14th St. Lane
 Greeley, CO 80634
 (303) 867-3715
 (303) 353-9747

R. 43W



*CORRECTED
 Location
 12-21-87
 15-199-20, 123-00-00*

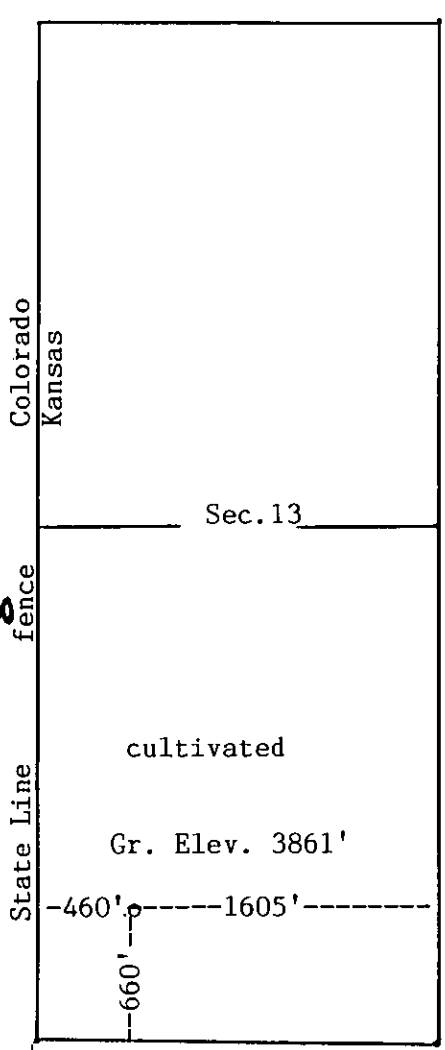

pipe

pipe

T.
14
S

RECEIVED
 STATE CONSERVATION COMMISSION
 DEC 16 1987
 CONSERVATION VISION
 Wichita, Kansas

Brass Cap

Scale --- 1" = 1000'

In accordance with a request from Union Pacific Resources Company
 the Undersigned has determined the location of the No.1 McKinney 34-13 well
 to be 660'FSL & 1605'FEL as co-ordinates
 Section 13 Township 14S Range 43W of the 6th principal Meridian
 Wallace County, Colorado, Kansas

I hereby certify,
 that this oil and/or gas well location certificate was prepared for Union Pacific Resources Company
 that it is not a land survey plat or improvement survey plat, and that it is not to be relied upon for the
 establishment of fence, building or other future improvement lines.

Date 11-24-87

B. J. Holloway
 Holloway & Holloway, Inc.
 States of
 Colorado, Nebraska, Wyoming