


STATE OF KANSAS
STATE CORPORATION COMMISSION
CONSERVATION DIVISION
P. O. BOX 17027
WICHITA, KANSAS 67317

FORM CP-4

WELL PLUGGING RECORD

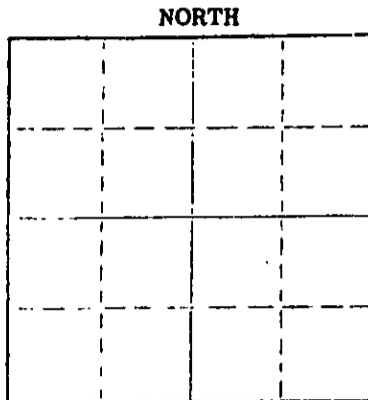

Locate well correctly on above Section Plat

Wallace County. Sec. 20 Twp. 15S Rge. (E) 38 (W)
Location as "NE/CNW&SW" or footage from lines. 1320' EN&W
Lease Owner PHILLIPS PETROLEUM COMPANY
Lease Name Allison 'D' Well No. 1
Office Address P. O. Box 358, Borger, Texas 79007
Character of Well (completed as Oil, Gas or Dry Hole) Dry Hole
Date well completed 7-14 1975
Application for plugging filed 7-14 1975
Application for plugging approved 7-14 1975
Plugging commenced 7-14 1975
Plugging completed 7-14 1975
Reason for abandonment of well or producing formation No commercial quantities of oil or gas encountered.
If a producing well is abandoned, date of last production 19
Was permission obtained from the Conservation Division or its agents before plugging was commenced? Yes

Name of Conservation Agent who supervised plugging of this well Gilbert Balthazor
Producing formation _____ Depth to top _____ Bottom _____ Total Depth of Well 5337 Feet
Show depth and thickness of all water, oil and gas formations.

OIL, GAS OR WATER RECORDS				CASING RECORD		
FORMATION	CONTENT	FROM	TO	SIZE	PUT IN	PULLED OUT
Surface Hole	Water	Surface	332	13-1/8"	334	None

Describe in detail the manner in which the well was plugged, indicating where the mud fluid was placed and the method or methods used in introducing it into the hole. If cement or other plugs were used, state the character of same and depth placed, from _____ feet to _____ feet for each plug set.

From 4850 to 5337, 185 sx cement;
4470 to 4600, 40 sx cement;
2920 to 3220, 120 sx cement;
282 to 382, 70 sx cement;
35 to 5, 10 sx cement;
Two sacks cement in rat hole.

RECEIVED
STATE CORPORATION COMMISSION
JUL 22 1975
CONSERVATION DIVISION
Wichita, Kansas

(If additional description is necessary, use BACK of this sheet)
Name of Plugging Contractor D N B DRILLING, INC.
Address 701 First National Building
Wichita, Kansas 67202
STATE OF KANSAS COUNTY OF _____
JAMES L. DONELSON (employee of owner) or (owner or operator) of the above-described

well, being first duly sworn on oath, says: That I have knowledge of the facts, statements, and matters herein contained and the log of the above-described well as filed and that the same are true and correct. So help me God.

(Signature) James L. Donelson
701 First Nat'l Bldg., Wichita, Ks.
(Address)

Subscribed and sworn to before me this 17th day of July, 1975

My commission expires August 25, 1976
Ella Pries
Notary Public.

Ella Pries
STATE NOTARY PUBLIC
Sedgwick County, Kansas
My Com. Expires Aug. 25, 1976

15-199-20007-0000

DRILLERS' LOG

PHILLIPS PETROLEUM COMPANY
No. 1 Allison 'D'
1320' FN&WL Sec. 20-15S-38W
Wallace County, Kansas

Elev:

Commenced: 6-30-75
Completed: 7-13-75

Surface: 334' of 13-3/8"
cemented w/600 sx Class H.
Cement w/3% cc. 7-1-75

<u>FORMATION</u>	<u>DEPTH</u>
Surface Hole	0 - 332
Shale	332 - 1120
Shale & Sand Stringers	1120 - 1694
Shale	1694 - 2024
Lime & Shale	2024 - 2485
Shale & Lime	2485 - 2651
Anhydrite	2651 - 2673
Shale & Lime	2673 - 2800
Lime & Shale	2800 - 3500
Lime	3500 - 5337 RTD

I do hereby certify that the foregoing statements are true and correct to the best of my knowledge and belief.

D N B DRILLING, INC.

James L. Donelson
JAMES L. DONELSON

RECEIVED
STATE CONSERVATION COMMISSION

JUL 22 1975

CONSERVATION DIVISION
Wichita, Kansas

STATE OF KANSAS: ss:

Subscribed and sworn to before me this 17th day of July, 1975.

My Commission Expires:
August 25, 1976

Ella Priess
Ella Priess, Notary Public

<i>Ella Priess</i>
STATE NOTARY PUBLIC
Sedgwick County, Kansas
My Com. Expires Aug. 25, 1976