


STATE OF KANSAS  
STATE CORPORATION COMMISSION  
200 Colorado Derby Bldg.  
Wichita, Kansas 67202

Form CP-4  
Rev. 12-15-80

WELL PLUGGING RECORD

Give All Information Completely  
Make Required Affidavit

COUNTY Wallace SEC. 19 TWP. 15S RGE. 38W  
Location as in quarters or footage from lines:  
C SE

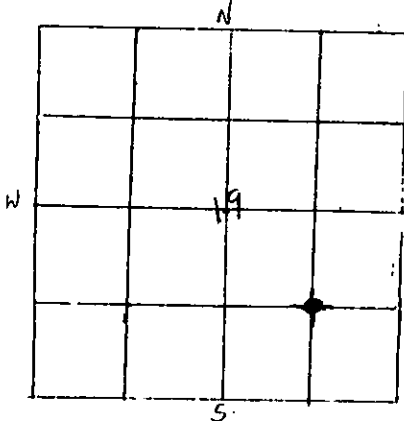

Locate Well  
correctly on above  
Section Platt.

Lease Owner Sunburst Exploration # 5005  
Lease Name Linder 'B' Well No. 1  
Office Address 708 One Main Pl. Wichita, KS 67530  
Character of Well (Completed as Oil, Gas or Dry Hole): DRY HOLE  
Date Well Completed 8-21-83  
Application for plugging filed 8-20-83  
Plugging commenced 8-21-83  
Plugging completed 8-21-83  
Reason for abandonment of well or producing formation DRY HOLE

Was permission obtained from the Conservation Division or it's  
Agent's before plugging was commenced? YES

Name of Conservation Agent who supervised plugging of this well Marion Schmidt  
Producing formation \_\_\_\_\_ Depth to top \_\_\_\_\_ bottom \_\_\_\_\_ T.D. 5295'

Show depth and thickness of all water, oil and gas formations.

OIL, GAS OR WATER RECORDS

Casing Record

Formation	Content	From	To	Size	Put in	Pulled Out
		0	367'	13 3/8	324'	0

Describe in detail the manner in which the well was plugged, indicating where the mud fluid was placed and the method or methods used in introducing it into the hold. If cement or other plugs were used, state the character of same and depth placed, from \_\_\_\_\_ feet to \_\_\_\_\_ feet for each plug set.

5295' T.D. 355 Sacks 50-50 Posmix 6% Gel 3% cc  
 1st Plug at 2640' with 40 Sacks  
 2nd Plug at 1620' with 200 Sacks  
 3rd Plug at 330' with 75 Sacks  
 40' Solid Bridge with 20 Sacks  
 Rathole 10 Sacks  
 Water Well 10 Sacks  
 Plug down 6:30 A.M. 8-21-83 Marion Schmidt, State Plugger

RECEIVED  
STATE CORPORATION COMMISSION  
SEP 1 1983 09-01-83  
CONSERVATION DIVISION  
Wichita, Kansas

(If additional description is necessary, use BACK of this sheet)

Name of Plugging Contractor BLUE GOOSE DRILLING COMPANY, INC. # 5104

STATE OF KANSAS COUNTY OF BARTON, ss.

George E. Miller, Jr. (employee of owner) or (owner or operator) of the above-described well, being first duly sworn on oath, says: That I have knowledge of the facts, statements, and matters herein contained and the log of the above-described well as filed and that the same are true and correct. So help me God.

(Signature) George E. Miller, Jr.  
PO Box 1413, Great Bend, KS 67530  
(Address)

SUBSCRIBED AND SWORN TO before me this 24th day of August, 19 83

Helen C. Standley  
Helen C. Standley Notary Public.

My Commission expires: 12-8-83

