


STATE OF KANSAS
STATE CORPORATION COMMISSION

WELL PLUGGING RECORD

12-17-76

Give All Information Completely
Make Required Affidavit
Mail or Deliver Report to
Conservation Division
State Corporation Comm.
245 North Water
Wichita, KS 67202

Wallace County. Sec. 16 Twp. 15S Rge. 39W E/W
Location as "NE/CNW $\frac{1}{4}$ SW $\frac{1}{4}$ " or footage from lines
NW NW SW
Lease Owner Wichita Industries, Inc.
Lease Name Frazier Farm Well No. 1
Office Address 1700 Broadway, Suite 1215, Denver, Col.
Character of Well (Completed as Oil, Gas or Dry Hole) Dry Hole

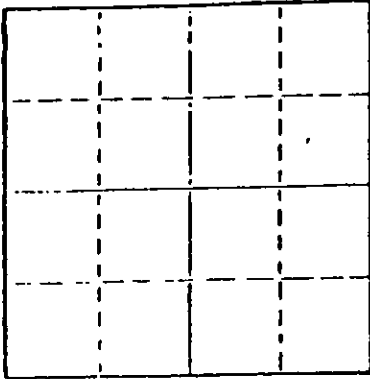

Locate well correctly on above
Section Plat

Date Well completed 12-7 19 76
Application for plugging filed 12-7 19 76
Application for plugging approved 12-7 19 76
Plugging commenced 12-7 19 76
Plugging completed 12-7 19 76

Reason for abandonment of well or producing formation
No commercial quantities of oil or gas encountered.
If a producing well is abandoned, date of last production
19

Was permission obtained from the Conservation Division or
its agents before plugging was commenced? Yes

Name of Conservation Agent who supervised plugging of this well Gilbert Balthazor
Producing formation _____ Depth to top _____ Bottom _____ Total Depth of Well 5550
Show depth and thickness of all water, oil and gas formations.

OIL, GAS OR WATER RECORDS

CASING RECORD

FORMATION	CONTENT	FROM	TO	SIZE	PUT IN	PULLED OUT
Surface Hole	Shale	Surf	330	8-5/8"	322	None

Describe in detail the manner in which the well was plugged, indicating where the mud fluid
was placed and the method or methods used in introducing it into the hold. If cement or other
plugs were used, state the character of same and depth placed, from _____ feet to
_____ feet for each plug set.

Fluid to 1250', plug, 70 sx cement;
Fluid to 300', plug, 20 sx cement;
Fluid to 40', plug, 10 sx cement.

(If additional description is necessary, use BACK of this sheet)

Name of Plugging Contractor D N B DRILLING, INC.
701 First National Building
Wichita, Kansas 67202

STATE OF KANSAS COUNTY OF _____, ss.
JAMES L. DONELSON (employee of owner) or (owner or operator)
of the above-described well, being first duly sworn on oath, says: That I have knowledge of
the facts, statements, and matters herein contained and the log of the above-described well
as filed and that the same are true and correct. So help me God.

(Signature) James L. Donelson


(Address) _____

SUBSCRIBED AND SWORN TO before me this 10th day of Dec., 19 76

Ella Priess
Notary Public.

My commission expires 8-25-80

Ella Priess

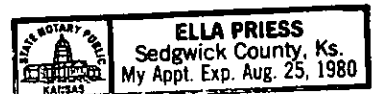

15-199-20011-00-00

DRILLERS' LOG

WICHITA INDUSTRIES, INC.
1700 Broadway, Suite 1215
Denver, Colorado 80202

No. 1 Frazier Farms
NW NW SW, Sec. 16-15S-39W
Wallace County, Kansas

Elev: 3625 K.B.

Commenced: 11-23-76
Completed: 12- 6-76

Surface Casing: 322.28/ of
8-5/8" cemented w/230 Class H
cement, 2 1/2 cc. 11-24-76

FORMATION

DEPTH

Surface Hole	0 - 330
Shale & Shells	330 - 1140
Shale	1140 - 1507
Sand & Shale	1507 - 1920
Shale & Sand	1920 - 2560
Lime & Shale	2560 - 3382
Shale & Lime	3382 - 3620
Lime & Shale	3620 - 4080
Shale	4080 - 4232
Lime & Shale	4232 - 4575
Shale	4575 - 4664
Shale & lime	4664 - 4778
Lime	4778 - 4867
Shale	4867 - 4956
Lime	4956 - 5090
Shale	5090 - 5171
Lime & Shale	5171 - 5399
Lime, Shale & Chert	5399 - 5500
Lime & Shale	4400 - 5550 RTD

I do hereby certify that the foregoing statements are true and correct to the best of my knowledge and belief.

D N B DRILLING, INC.

James L. Donelson
JAMES L. DONELSON

STATE OF KANSAS: ss:

Subscribed and sworn to before me this 8th day of December, 1976.

Ella Priess
Ella Priess, Notary Public

