


Give All Information Completely  
Make Required Affidavit  
Mail or Deliver Report to:  
Conservation Division  
State Corporation Commission  
211 No. Broadway  
Wichita, Kansas

WELL PLUGGING RECORD

Scott County, Sec. 29 Twp. 20S Rge. 34W (E) (W)

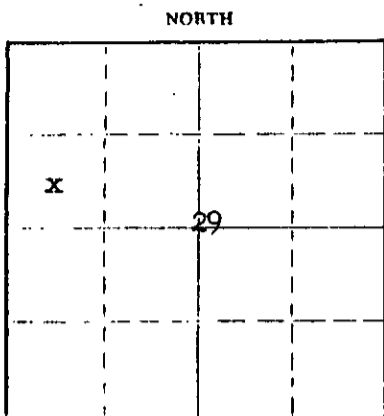

Locate well correctly on above Section Plat

Location as "NE/CNW/SW" or footage from lines \_\_\_\_\_  
Lease Owner Cities Service Oil Company  
Lease Name Pfeffinger A Well No. 1  
Office Address P. O. Box 6, Liberal, Kansas  
Character of Well (completed as Oil, Gas or Dry Hole) Oil  
Date well completed August 2 19 66  
Application for plugging filed May 1 19 67  
Application for plugging approved May 2 19 67  
Plugging commenced May 2 19 67  
Plugging completed May 4 19 67  
Reason for abandonment of well or producing formation Depleted

If a producing well is abandoned, date of last production April 21 19 67  
Was permission obtained from the Conservation Division or its agents before plugging was commenced? Yes

Name of Conservation Agent who supervised plugging of this well W. L. Nichols  
Producing formation Marmaton Depth to top 4500 Bottom 4650 Total Depth of Well 4663 Feet  
Show depth and thickness of all water, oil and gas formations.

OIL, GAS OR WATER RECORDS

CASING RECORD

FORMATION	CONTENT	FROM	TO	SIZE	PUT IN	PULLED OUT
<u>Marmaton</u>	<u>Oil &amp; Water</u>	<u>4558</u>	<u>4610</u>	<u>8 5/8</u> <u>4 1/2</u>	<u>452</u> <u>4660</u>	<u>None</u> <u>3400</u>

Describe in detail the manner in which the well was plugged, indicating where the mud fluid was placed and the method or methods used in introducing it into the hole. If cement or other plugs were used, state the character of same and depth placed, from \_\_\_\_\_ feet to \_\_\_\_\_ feet for each plug set.

4500 - 4200 25 sx cement plug - Pump truck  
4200 - 700 Mud  
700 - 640 20 sx cement plug - Pump truck  
640 - 400 Mud  
400 - 340 20 sx cement plug - Pump truck  
340 - 30 Mud  
30 - 0 5 sx cement Dumped

STATE CORPORATION COMMISSION  
MAY 12 1967  
5-12-67  
CONSERVATION DIVISION  
Wichita, Kansas

(If additional description is necessary, use BACK of this sheet)  
Name of Plugging Contractor Sargent's Casing Pulling  
Address Liberal, Kansas

STATE OF Kansas COUNTY OF Seward ss.  
C. A. Nenny (employee of owner) or owner of the above-described well, being first duly sworn on oath, says: That I have knowledge of the facts, statements, and matters herein contained and the log of the above-described well as filed and that the same are true and correct. So help me God.

(Signature) C. A. Nenny  
P. O. Box 6, Liberal, Kansas  
(Address)

SUBSCRIBED AND SWORN TO before me this 11th day of May, 19 67

My commission expires 11-5-70

Calvin Lindsey  
Calvin Lindsey Notary Public.

# WELL LOG

15171-30067-0000

COMPANY Cities Service

SEC. 29, 20S R. 34W  
LOC. C SW SW

FARM Pfeffinger "A" NO. One

RIG. NO. 2

TOTAL DEPTH 4660'

COUNTRY Scott - Kansas  
KANSAS


COMM. 8-6-66

COMP. 8-18-66

SHOT OR TREATED

CONTRACTOR Murfin Drilling Company

ISSUED

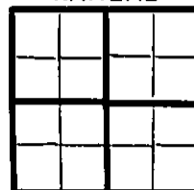

### CASING

20	10
15	8 5/8" 452' w/275 sacks
12	6
13	5
	4 1/2" 4659' w/175 sacks

ELEVATION 2950 GR (9.80' from gr to KB)

PRODUCTION Oil

FIGURES INDICATE BOTTOM OF FORMATIONS

100	Surface Clay
140	Sand
480	Shale - Shells
530	Shale
1985	Shale & Shells
2240	Shells - Salt - Red Bed
2259	Anhydrite
2265	Shale
2501	Shale - Shells
3200	Lime & Shale
3575	Lime
3816	Lime - Shale
4660	Lime

RECEIVED  
 STATE OF KANSAS  
 MAY - 8 - 1967  
 COMMISSION DIVISION  
 TOPEKA, KANSAS

State of KANSAS }  
 County of SEDGWICK } ss:

I, W.R. Murfin of the Murfin Drilling Company

upon oath state that the above and foregoing is a true and correct copy of the log of the Pfeffinger "A" #1 well.

W.R. Murfin  
 W.R. Murfin

Subscribed and sworn to before me this 1st day of September 19 66

My Commission Expires: ADELA MIZENER, Notary Public  
 My commission expires November 5, 1966

Adela Mizener  
 NOTARY PUBLIC