


C-KC JWH

STATE OF KANSAS
STATE CORPORATION COMMISSION

WELL PLUGGING RECORD

Give All Information Completely
Make Required Affidavit
Mail or Deliver Report to
Conservation Division
State Corporation Comm.
245 North Water
Wichita, KS 67202

Scott County, Sec. 12 Twp. 20 Rge. 34 E/4
Location as "NE/CNW $\frac{1}{2}$ SW $\frac{1}{2}$ " or footage from lines C-NE
Lease Owner Maurice L. Brown
Lease Name Lang A Well No. 2
Office Address P.O. Box 11320, Kansas City, Mo. 64112
Character of Well (Completed as Oil, Gas or Dry Hole) Gas
Date Well completed 8-3-77 19
Application for plugging filed 2-1-82 19
Application for plugging approved 2-12-82 19
Plugging commenced 4-27-82 19
Plugging completed 4-29-82 19
Reason for abandonment of well or producing formation Non commercial value
If a producing well is abandoned, date of last production 4-20-82 19

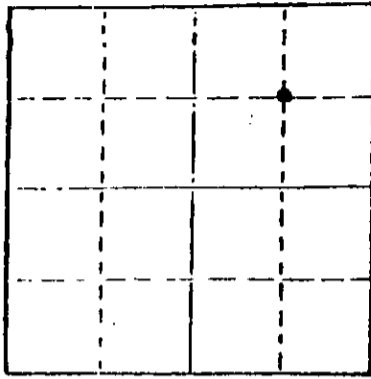

Locate well correctly on above Section Flat

Was permission obtained from the Conservation Division or its agents before plugging was commenced? yes
Name of Conservation Agent who supervised plugging of this well Mr. Duvant
Producing formation Hugoton Depth to top 2652' Bottom 2668' Total Depth of Well 2835'
Show depth and thickness of all water, oil and gas formations.

OIL, GAS OR WATER RECORDS

CASING RECORD

FORMATION	CONTENT	FROM	TO	SIZE	PUT IN	PULLED OUT
Krider	Gas	2652	2665			
Surface				8 5/8"	365'	0'
Production				4 1/2"	2823'	1321'

Describe in detail the manner in which the well was plugged, indicating where the mud fluid was placed and the method or methods used in introducing it into the hold. If cement or other plugs were used, state the character of same and depth placed, from feet to feet for each plug set.

Plug perforations w/1 sk. hulls & 20 sks. cement
Pumped 50 sks. cement 850' to 650'
Layed down to 365'
Pumped 70 sks. cement 365' to 0'
Layed down rest of 4 1/2"
Filled hole w/10 sks. cement to 0'
Cut off 8 5/8", 3' below ground level & weld plate on same

RECEIVED
STATE CORPORATION COMMISSION
MAY 10 1982
5-10-82
CONSERVATION DIVISION
Wichita Kansas

(If additional description is necessary, use BACK of this sheet)

Name of Plugging Contractor Midwest Casing Pulling Service
Permit # 766

STATE OF KANSAS COUNTY OF HASKELL, ss.
I, Edgar J. Eves (Employee of owner) or (owner or operator)

of the above-described well, being first duly sworn on oath, says: That I have knowledge of the facts, statements, and matters herein contained and the log of the above-described well as filed and that the same are true and correct. So help me God.

(Signature) Edgar J. Eves
Box F, Soblette, Ks. 67877
(Address)

SUBSCRIBED AND SWORN TO before me this 4th day of April, 1982

Sondra L Eves
Notary Public.

My commission expires 12-6-84



RECEIVED
STATE CONSERVATION COMMISSION

FEB 11 1982

CONSERVATION DIVISION
MOUNTAIN VIEW, KANSAS

DRILLERS LOG

LANG "A" NO. 2

CASING RECORD;	OPERATOR: Maurice L. Brown Company	DESCRIPTION:
8-5/8" set @ 365.13' w/300 sax cement	CONTRACTOR: Sage Drilling Co., Inc.	C NE/4 Sec. 12-20S-34W Scott Co., Kans.
TOTAL DEPTH; 2835'	COMMENCED: June 7, 1977	ELEVATION: 3007KB
	COMPLETED: June 14, 1977	

<u>FORMATION</u>	<u>FROM</u>	<u>TO</u>	<u>REMARKS</u>
Surface Soil & Clay	0	370	
Shale	370	650	
Shale & Sand	650	1810	
Sand & Shale	1810	2232	
Shale & Lime	2232	2630	
Lime & Shale	2630	2835	Ran DST#1 @ 2680' Logged Hole 4 1/2" set @ 2823' w/325 sax cement

I certify that this is a true and correct copy of the log on the above captioned well to the best of my knowledge.

SAGE DRILLING CO., INC.

By John R. Bartholomew
John R. Bartholomew

Subscribed and sworn to before me this 21st day of June, 1977.

Louise K. Whitted
Louise K. Whitted - Notary Public

My commission expires:
November 26, 1978.

