


STATE OF KANSAS
STATE CORPORATION COMMISSION

Form CP-4

WELL PLUGGING RECORD

Give All Information Completely
Make Required Affidavit
Mail or Deliver Report to:
Conservation Division
State Corporation Commission
212 No. Market
Wichita, Kansas

NORTH

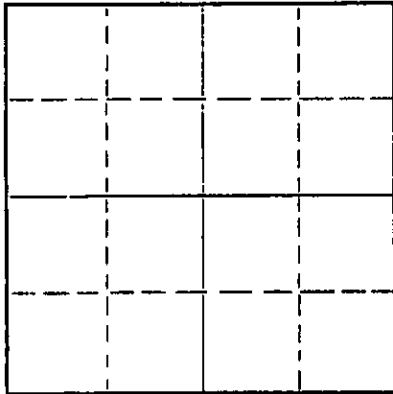

Locate well correctly on above
Section Plat

Location as "NE/CNWKSWK" or footage from lines C SW NE
Lease Owner Scott County, Sec. 20 Twp 20S Rge. 34W (E) (W)
Leben Drilling, Inc. etal
Lease Name Easton Well No. 1
Office Address Box 486, Great Bend, Kansas 67530
Character of Well (completed as Oil, Gas or Dry Hole) Dry Hole
Date well completed 7-26-67 19
Application for plugging filed 7-26-67 19
Application for plugging approved 7-26-67 19
Plugging commenced 7-26-67 19
Plugging completed 7-26-67 19
Reason for abandonment of well or producing formation Dry Hole

If a producing well is abandoned, date of last production 19
Was permission obtained from the Conservation Division or its agents before plugging was commenced? yes

Name of Conservation Agent who supervised plugging of this well W. L. Nichols
Producing formation _____ Depth to top _____ Bottom _____ Total Depth of Well 5150 Feet
Show depth and thickness of all water, oil and gas formations.

OIL, GAS OR WATER RECORDS

CASING RECORD

FORMATION	CONTENT	FROM	TO	SIZE	PUT IN	PULLED OUT
				8 5/8"	445'	none

Describe in detail the manner in which the well was plugged, indicating where the mud fluid was placed and the method or methods used in introducing it into the hole. If cement or other plugs were used, state the character of same and depth placed, from _____ feet to _____ feet for each plug set.

Spotted with 100 sacks Posmix @ 1980'; laying down drill pipe to 440'
Spotted with 20 sks. cement, Plug @ 40' - 1/2 sk. hulls, 10 sks. cement

STATE CORPORATION COMMISSION
JUL 28 1967
7-28-67
CONSERVATION DIVISION
WICHITA, KANSAS

(If additional description is necessary, use BACK of this sheet)
Name of Plugging Contractor Leben Drilling, Inc.
Address Box 486, Great Bend, Kansas 67530

STATE OF KANSAS, COUNTY OF BARTON, ss.
Leslie Kite (employee of owner) or (owner or operator) of the above-described well, being first duly sworn on oath, says: That I have knowledge of the facts, statements, and matters herein contained and the log of the above-described well as filed and that the same are true and correct. So help me God.

(Signature) Leslie Kite
Box 486, Great Bend, Kansas 67530
(Address)

SUBSCRIBED AND SWORN TO before me this 27th day of July, 1967
Ulanda Nichols
Notary Public.

My commission expires April 1, 1971

DRILLER'S LOG

COMPANY: Leben Drilling, Inc. etal
 CONTRACTOR: LEBEN DRILLING, INC.
 FARM: EASTON #1
 LOCATION: C SW NE SEC. 20-20S-34W
 SCOTT COUNTY, KANSAS
 COMMENCED: 7-8-67
 COMPLETED: 7-26-67

0	80	Shale, Clay
80	130	Sand
130	1045	Shale
1045	1475	Shale, Redbed
1475	2353	Shale
2353	2864	Lime, Shale
2864	3180	Lime
3180	3295	Lime, Shale
3295	3670	Lime
3670	3782	Chalky Lime
3782	3879	Lime
3879	3954	Chalky Lime
3954	5098	Lime
5098	5150	Mississippi Lime
	<u>5150</u>	<u>RTD - D. & A.</u>

NOTARY PUBLIC
 STATE OF KANSAS
 COMMISSION EXPIRES
 JUL 28 1967
 CONSERVATION DIVISION
 WICHITA, KANSAS

8 5/8" new 20# surface casing set @ 445' cemented with 350 sacks
 Common, 2% cc

I, Leslie Kite, do hereby certify that the above and foregoing is
 a true and correct copy of the log of the Easton #1 Well, located
 C SW NE of Section 20, Township 20 South, Range 34 West, Scott County,
 Kansas, as reflected by the records of Leben Drilling, Inc.

Leslie Kite
 Leslie Kite

STATE OF KANSAS)
) SS
 COUNTY OF BARTON)

Subscribed and sworn to and before me, a Notary Public, in
 and for Barton County, Kansas, this 27th day of July, 1967.

Ulanda Nichols
 Ulanda Nichols

My Commission Expires:
 April 1, 1971