


STATE OF KANSAS  
STATE CORPORATION COMMISSION

WELL PLUGGING RECORD

Give All Information Completely  
Make Required Affidavit  
Mail or Deliver Report to  
Conservation Division  
State Corporation Comm.  
• 245 North Water  
Wichita, KS 67202

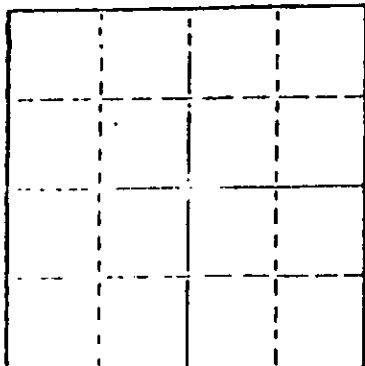

Locate well correctly on above  
Section Plot

Scott County, Sec. 24 Twp. 20S Rge. 34 XXW  
Location as "NE/CNW $\frac{1}{4}$ SW $\frac{1}{4}$ " or footage from lines  
C NE $\frac{1}{4}$   
Lease Owner The Maurice L. Brown Co.  
Lease Name R.L. CRIST "D" Well No. 2  
Office Address 200 Sutton Place, Wichita, Kansas  
Character of Well (Completed as Oil, Gas or Dry Hole)  
Dry Hole

Date Well completed 06-10 1980  
Application for plugging filed 06-10 1980  
Application for plugging approved 06-10 1980  
Plugging commenced 06-10 1980  
Plugging completed 06-10- 1980

Reason for abandonment of well or producing formation  
No commercial quantity of oil or gas encountered  
If a producing well is abandoned, date of last production  
19

Was permission obtained from the Conservation Division or  
its agents before plugging was commenced? Yes

Name of Conservation Agent who supervised plugging of this well Clarence Thomas  
Producing formation \_\_\_\_\_ Depth to top \_\_\_\_\_ Bottom \_\_\_\_\_ Total Depth of Well 2810'  
Show depth and thickness of all water, oil and gas formations.

OIL, GAS OR WATER RECORDS

CASING RECORD

FORMATION	CONTENT	FROM	TO	SIZE	PUT IN	PULLED OUT

Describe in detail the manner in which the well was plugged, indicating where the mud fluid  
was placed and the method or methods used in introducing it into the hole. If cement or other  
plugs were used, state the character of same and depth placed, from \_\_\_\_\_ feet to  
\_\_\_\_\_ feet for each plug set.

TD 2810'  
Set 1st plug at 750' with 70 sx.  
2nd plug at 350' with 20 sx.  
& rathole with 5 sx. cemented with  
50/50 posmix

Plug was down 12:30 p.m. 6-10-80

(If additional description is necessary, use BACK of this sheet)

Name of Plugging Contractor Abercrombie Drilling, Inc.

RECEIVED  
STATE CORPORATION COMMISSION  
JUL 27 1980

STATE OF Kansas COUNTY OF Sedgwick  
Jack L. Partridge, Asst. Sec.-Treas. (employee of owner) or (owner or operator)  
of the above-described well, being first duly sworn on oath, says: That I have knowledge of  
the facts, statements, and matters herein contained and the log of the above-described well  
as filed and that the same are true and correct. So help me God.

(Signature) Jack L. Partridge  
801 Union Center, Wichita, Kansas 67202  
(Address)

SUBSCRIBED AND SWORN TO before me this 26th day of June, 19 80.



My commission expires \_\_\_\_\_

Sherrie L. Brooks  
Sherrie L. Brooks Notary Public.

CONTRACTOR'S WELL LOG

15:171-20189-0000

OPERATOR: The Maurice L. Brown Co.  
 CONTRACTOR: Abercrombie Drilling, Inc.  
 WELL NAME: R. L. CRIST "D" #2  
 LOCATION: C NE/4, Section 30-20S-34W  
 Scott County, Kansas  
 SPUD DATE: 06-06-80  
 COMPLETION DATE: 06-10-80

0	75	Clay
75	400	Shale & Sand
400	1415	Shale
1415	1570	Shale & Sand
2020	2155	Shale
2155	2175	Anhydrite
2175	2475	Shale
2475	2660	Shale & Lime
2660	2810	Lime & Shale
	2810	Rotary Total Depth

Spud @ 2:00 p.m. Drilled 365' of 12 1/4" hole. Ran 9 joints of 8-5/8" - 24# casing. (Tally 356.85') Set at 364'. Cemented with 150 sacks of Halliburton Lite, 3% Ca. Cl., 1/4# Flocel, followed with 150 sacks of Class H cement, 3% Ca. Cl., 1/4# Flocel. Cement did circulate.

T.D. 2810'. Laying down drill pipe, preparing to plug. Plugging orders, set 1st plug at 750' with 70 sx. 2nd plug 350' with 20 sx & rathole with 5 sacks. Cemented 50/50 posmix, 6% gel. Plug down at 12:30 p.m., 06-10-80.

SAMPLE TOPS:

Anhydrite 2155'  
 B/Anhydrite 2171'

RECEIVED  
 STATE CORPORATION COMMISSION  
 JUL - 7 1980  
 CONSERVATION DIVISION  
 Wichita, Kansas


STATE OF KANSAS )  
 ) SS  
 COUNTY OF SEDGWICK )

Jack L. Partridge, Assistant Security-Treasurer of Abercrombie Drilling, Inc., does hereby state that the above and foregoing is a true and correct copy of the log of the R. L. CRIST "C" #1, C SE NW, Section 30-20S-33W, Scott County, Kansas.

ABERCROMBIE DRILLING, INC.

BY: Jack L. Partridge  
 Jack L. Partridge, Asst. Sec.-Treas.

Subscribed and sworn to before me, a Notary Public, in and for the aforesaid county and state as of this 26 day of June, 1980.

 SHERRIE L. BROOKS  
 Sedgwick County, Ks.  
 Exp. 8-21-82

Sherrie L. Brooks  
 Sherrie L. Brooks, Notary Public