

WELL PLUGGING RECORD


Give All Information Completely
Make Required Affidavit
Mail or Deliver Report to:
Conservation Division
State Corporation Commission
211 No. Broadway
Wichita, Kansas

Scott

County. Sec. 9 Twp. 20S Rge. 34 ~~xxx~~ (W)

Location as "NE/CNWxSWx" or footage from lines C/SW/SW/4
Lease Owner E. K. Edmiston
Lease Name Harkness Well No. 1
Office Address 501 First National Bank Bldg., Wichita, Ka.
Character of Well (completed as Oil, Gas or Dry Hole) dry hole
Date well completed May 11, 1963 19
Application for plugging filed May 11, 1963 19
Application for plugging approved May 11, 1963 19
Plugging commenced May 11, 1963 19
Plugging completed May 11, 1963 19
Reason for abandonment of well or producing formation dry hole

NORTH

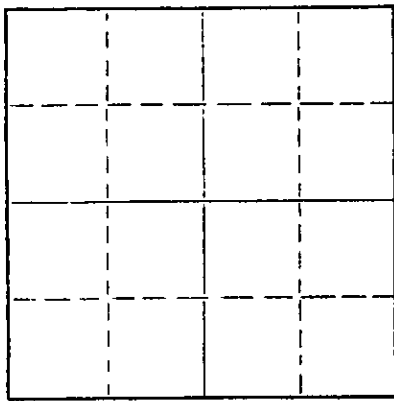

Locate well correctly on above Section Plat

If a producing well is abandoned, date of last production _____ 19
Was permission obtained from the Conservation Division or its agents before plugging was commenced? yes

Name of Conservation Agent who supervised plugging of this well Donald Truan
Producing formation _____ Depth to top _____ Bottom _____ Total Depth of Well 5038 Feet
Show depth and thickness of all water, oil and gas formations.

OIL, GAS OR WATER RECORDS

CASING RECORD

FORMATION	CONTENT	FROM	TO	SIZE	PUT IN	PULLED OUT
				8-5/8"	360'	

Describe in detail the manner in which the well was plugged, indicating where the mud fluid was placed and the method or methods used in introducing it into the hole. If cement or other plugs were used, state the character of same and depth placed, from _____ feet to _____ feet for each plug set.

- No. 1 plug 540 feet - 20 sacks
- No. 2 plug 360 feet - 20 sacks
- No. 3 plug 40 feet - 10 sacks

RECEIVED
STATE CORPORATION COMMISSION

MAY 24 1963

5-24-63

CONSERVATION DIVISION
Wichita, Kansas

(If additional description is necessary, use BACK of this sheet)
Name of Plugging Contractor E. K. Edmiston Drilling Co., Inc.
Address 501 First National Bank Building, Wichita, Kansas

STATE OF KANSAS, COUNTY OF SEDGWICK, ss.
E. K. Edmiston, ~~owner~~ operator of the above-described well, being first duly sworn on oath, says: That I have knowledge of the facts, statements, and matters herein contained and the log of the above-described well as filed and that the same are true and correct. So help me God.

(Signature) [Signature]

501 First National Bank Bldg., Wichita, Kansas
(Address)

SUBSCRIBED AND SWORN TO before me this 22nd day of May, 1963

My commission expires August 25, 1964

G. B. Bergew
Notary Public.



D R I L L E R ' S L O G

COMPANY: E. K. EDMISTON
501 First National Bank Building
Wichita 2, Kansas

ROTARY DRILLING COMMENCED: April 22, 1963

ROTARY DRILLING COMPLETED: May 12, 1963

WELL NAME: No. 1 HARKNESS
C SW SW Section 9-20S-34W
Scott County, Kansas

CONTRACTOR: E. K. EDMISTON DRILLING CO., INC.
501 First National Bank Building
Wichita, Kansas

CASING RECORD: 8-58-" @ 360 w/ 250 sacks

L O G

Measurements from top of Rotary Bushing:

0 - 60	Sand
60 - 200	Sand and Shale
200 - 800	Shale
800 - 1200	Shale and Sand
1200 - 1480	Red Shale
1480 - 2004	Shale
2004 - 2275	Shale and Lime
2275 - 2320	Anhydrite
2320 - 2490	Shale and Lime
2490 - 2635	Lime
2635 - 3008	Lime and Shale
3008 - 4114	Lime
4114 - 4127	Chalk
4127 - 4189	Chalk and Lime
4189 - 4261	Lime and Chalk
4261 - 4567	Lime
4567 - 4594	Lime and Shale
4594 - 5038	Lime
5038	<u>Rotary Total Depth</u>

RECEIVED
STATE CORPORATION COMMISSION

MAY 24 1963

REGISTRATION DIVISION
Wichita, Kansas

The undersigned, E. K. Edmiston, President of E. K. Edmiston Drilling Co., Inc., hereby certifies on behalf of said company that the above log is a true and correct log of the formations encountered in drilling the above well as reflected by the Daily Drilling Reports.

E. K. EDMISTON DRILLING CO., INC.

E. K. Edmiston

E. K. Edmiston, President

STATE OF KANSAS,
SS:
SEDGWICK COUNTY,

BE IT REMEMBERED that on this 23rd day of May, 1963, before me, the undersigned, a Notary Public duly commissioned in and for the state and county aforesaid, came E. K. Edmiston, known to me to be the same person who executed the foregoing instrument as President and on behalf of the E. K. Edmiston Drilling Co., Inc., and he duly acknowledged the execution of the same for himself and for said company.

WITNESS WHEREOF, I have hereunto set my hand and official seal on _____ day and year last above written.

A. B. Barger

A. B. Barger, Notary Public

