


WELL PLUGGING RECORD

Give All Information Completely
Make Required Affidavit
Mail or Deliver Report to:
Conservation Division
State Corporation Commission
211 No. Broadway
Wichita, Kansas

Scott County. Sec. 31 Twp. 20 Rge. 32 (E) (W)

Location as "NE/CNW&SW" or footage from lines Center SF
Lease Owner Clarence Seeber
Lease Name Seeber Well No. Fee 1
Office Address Box 164, El Dorado, Kansas
Character of Well (completed as Oil, Gas or Dry Hole) Dry Hole
Date well completed 5-22-65 19 65
Application for plugging filed 19
Application for plugging approved 19
Plugging commenced May 22 19 65
Plugging completed May 22 19 65
Reason for abandonment of well or producing formation No Gas or Oil

NORTH

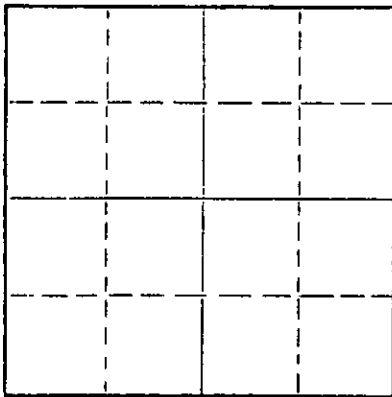

Locate well correctly on above
Section Plat

If a producing well is abandoned, date of last production None 19
Was permission obtained from the Conservation Division or its agents before plugging was commenced? No Testing other zones

Name of Conservation Agent who supervised plugging of this well
Producing formation Depth to top Bottom Total Depth of Well Feet
Show depth and thickness of all water, oil and gas formations.

OIL, GAS OR WATER RECORDS

CASING RECORD

FORMATION	CONTENT	FROM	TO	SIZE	PUT IN	PULLED OUT

Describe in detail the manner in which the well was plugged, indicating where the mud fluid was placed and the method or methods used in introducing it into the hole. If cement or other plugs were used, state the character of same and depth placed, from feet to feet for each plug set.

100 Sacks mixed by United Oil Well Cementing Co.,
Pumped in at 2700. Other zones up hole perforated, no production
Attempted to pull pipe, 6" stretch all we could get
Shot pipe off at 700' Placed 25 sacks from 700' up to 575'
Pulled pipe to 400'. 25 Sacks placed thru 4 inch, from 400' up to 275'
Surface pipe left in for irrigation well. 350' of seven inch pipe

RECEIVED
STATE CORPORATION COMMISSION

SEP 24 1965

9-24-65

CONSERVATION DIVISION
Wichita, Kansas

(If additional description is necessary, use BACK of this sheet)

Name of Plugging Contractor Bill Hays
Address Great Bend, Kansas

STATE OF Kansas COUNTY OF Butler, ss.
Clarence Seeber (employee of owner) or (conservation agent)

well, being first duly sworn on oath, says: That I have knowledge of the facts, statements, and matters herein contained and the log of the above-described well as filed and that the same are true and correct. So help me God.

(Signature) Clarence Seeber

P.O. Box 164, El Dorado, Kansas
(Address)

SUBSCRIBED AND SWORN TO before me this 23 day of Sept., 19 65

My commission expires March 20, 1969

Notary Public