

STATE OF KANSAS
STATE CORPORATION COMMISSION

Form CP-4

Give All Information Completely
Make Required Affidavit
Mail or Deliver Report to:
Conservation Division
State Corporation Commission
212 No. Market
Wichita, Kansas 67202

WELL PLUGGING RECORD

Scott County, Sec. 29 Twp. 20S Rge. (X) 32 (W)

Location as "NE/CNW/SW" or footage from lines 660' FSL - 1880' FEL

Lease Owner Cities Service Oil Company

Lease Name DAGUE-WING A Well No. 1

Office Address 3545 N.W. 58th St., Okla. City, Oklahoma 73112

Character of Well (completed as Oil, Gas or Dry Hole) Dry Hole

Date well completed January 23 1974

Application for plugging filed N.A. 19

Application for plugging approved N.A. 19


Plugging commenced January 23 1974

Plugging completed January 24 1974

Reason for abandonment of well or producing formation Dry Hole

If a producing well is abandoned, date of last production N.A. 19

Was permission obtained from the Conservation Division or its agents before plugging was commenced? yes

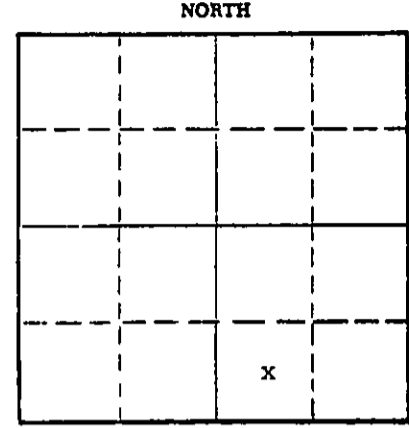

Locate well correctly on above Section Plat

Name of Conservation Agent who supervised plugging of this well E. Eves, Subst. W.L. NICHOLS MORLAND, KAN

Producing formation N.A. Depth to top Bottom Total Depth of Well 4136 Feet

Show depth and thickness of all water, oil and gas formations.

OIL, GAS OR WATER RECORDS

CASING RECORD

FORMATION	CONTENT	FROM	TO	SIZE	PUT IN	PULLED OUT
Kinder	dry	2622	2717	16"	72	None
Mississippi	dry	4806	4975	8-5/8"	1439	None
Marmaton	dry	4435	4494			

Describe in detail the manner in which the well was plugged, indicating where the mud fluid was placed and the method or methods used in introducing it into the hole. If cement or other plugs were used, state the character of same and depth placed, from --- feet to --- feet for each plug set.

Ran open end drill pipe and spotted 50 sxs cement plug from 1500-1300'. Then spotted 10 sxs cement plug from 40-4' below ground level, at which point the 8-5/8" casing was cut off and a steel cap with well name and date plate was welded on. Filled rat hole and mouse hole with 5 sxs each.

RECEIVED
STATE CORPORATION COMMISSION
FEB 4 1974
2-9-74
CONSERVATION DIVISION
WICHITA, KANSAS

(If additional description is necessary, use BACK of this sheet)
Name of Plugging Contractor Sterling Drilling Company
Address Sterling, Kansas

STATE OF OKLAHOMA, COUNTY OF OKLAHOMA ss.
I, H. E. Massey (employee of owner) or (owner or operator) of the above-described

well, being first duly sworn on oath, says: That I have knowledge of the facts, statements, and matters herein contained and the log of the above-described well as filed and that the same are true and correct. So help me God.

(Signature) H. E. Massey Operations Manager

3545 N.W. 58th, Oklahoma City, Okla. 73112 (Address)

SUBSCRIBED AND SWORN TO before me this 1st day of February, 1974

My commission expires April 2, 1977

C.R. Paslay
C.R. Paslay Notary Public

FORMATION, TESTING AND COMPLETION RECORD

Show Drill Stem Tests,
Well Stimulation and
Production Tests

Formation	Top	Bottom	
Clay, Sd, Shale	0	740	DST #1 Krider 2622-2717' - No Test
Shale & Sand	740	1285	DST #1A Krider 2622-2717' - Not Test
Shale	1285	1555	DST #2 Mississippi 4806-4850'
Anhy & Shale	1555	1700	DST #3 Mississippi 4862-4900'
Sand	1700	1840	DST #4 Mississippi 4911-4975'
Shale	1840	2073	DST #5 Marmaton 4435-4494'
Lime & Shale	2073	3980	-----
Lime	3980	4135	Well Not Stimulated
Lime & Shale	4135	4215	-----
Lime	4215	4395	
Lime & Shale	4395	4475	
Lime	4475	4590	
Lime & Shale	4590	4825	
Lime	4825	4855	
Mississippi	4855	4940	
Lime & Shale	4940	4975	
Lime	4975	5136	
Total Depth	5136		

RECEIVED
STATE CORPORATION COMMISSION
FEB 4 1974
CONSERVATION DIVISION
Wichita, Kansas