


STATE OF KANSAS
STATE CORPORATION COMMISSION

Give All Information Completely
Make Required Affidavit
Mail or Deliver Report to:
Conservation Division
State Corporation Commission
212 North Market, Insurance Bldg.
Wichita, Kansas

WELL PLUGGING RECORD

Scott County, Sec. 17 Twp. 20-S Rge. (E) 31 (W)

Location as "NE/CNWxSWx" or footage from lines. C SW NE
Lease Owner Socony Mobil Oil Co., Inc.
Lease Name Hutchins Estate Well No. 1
Office Address 300 North Broadway, Wichita, Kansas
Character of Well (completed as Oil, Gas or Dry Hole) Dry Hole
Date well completed September 6, 19 62
Application for plugging filed September 6, 19 62
Application for plugging approved September 6, 19 62
Plugging commenced September 6, 19 62
Plugging completed September 6, 19 62
Reason for abandonment of well or producing formation Drilled Dry No Commercial Production

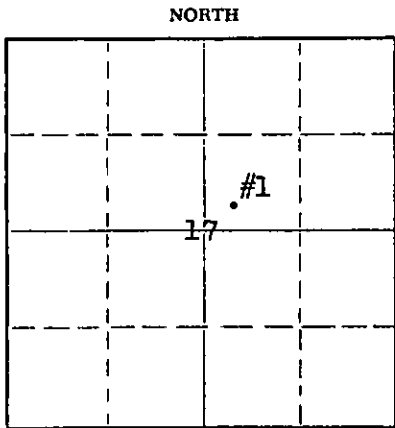

Locate well correctly on above Section Plat

If a producing well is abandoned, date of last production 19
Was permission obtained from the Conservation Division or its agents before plugging was commenced? yes

Name of Conservation Agent who supervised plugging of this well Eldon Petty
Producing formation Depth to top Bottom Total Depth of Well 5450 Feet
Show depth and thickness of all water, oil and gas formations.

OIL, GAS OR WATER RECORDS

CASING RECORD

FORMATION	CONTENT	FROM	TO	SIZE	PUT IN	PULLED OUT
None				8-5/8"	2100'	None

Describe in detail the manner in which the well was plugged, indicating where the mud fluid was placed and the method or methods used in introducing it into the hole. If cement or other plugs were used, state the character of same and depth placed, from feet to feet for each plug set.
Mud 5450' - 600', 20 sx cement from 600' - 530', mud 530' - 240', 20 sx cement 240' - 170', Mud 170' - 40', and 10 sx cement from 40' to surface.

9-14-62

(If additional description is necessary, use BACK of this sheet)

Name of Plugging Contractor Strata Drilling, Inc.
Address 2421 Tenth Street, Great Bend, Kansas

STATE OF Kansas COUNTY OF Sedgwick ss.

A. P. Lobrecht (employee of owner) of the above-described well, being first duly sworn on oath, says: That I have knowledge of the facts, statements, and matters herein contained and the log of the above-described well as filed and that the same are true and correct. So help me God.

(Signature) A. P. Lobrecht
300 North Broadway, Wichita, Kansas (Address)

SUBSCRIBED AND SWORN TO before me this 12th day of September, 19 62

My commission expires April 4, 1966 Notary Public. Jackie Bearden

WELL LOG BUREAU—KANSAS GEOLOGICAL SOCIETY
508 East Murdock, Wichita, Kansas


15-71-00061-0000

Company- MOBIL OIL COMPANY
Farm- Hutchins' Estate No. 1

SEC. 17 T. 20 R. 31W
C SW NE

Total Depth. 5450'
Comm. 8-13-62 Comp. 9-5-62
Shot or Treated.
Contractor. Strata Drilling, Inc.
Issued. 12-8-62

County Scott
KANSAS

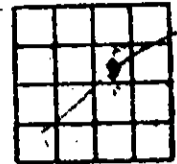

CASING:
8 5/8" 2110' cem w/1100 sx.

Elevation. 2868' DF

Production. DRY

Figures Indicate Bottom of Formations.

sand & clay	150
shale	1000
shale w/streaks of br lime	1350
shale & shells	1585
anhydrite	1625
shale & red bed	2111
lime & shale	2320
shale & lime streaks	2550
lime & shale	3165
lime	3245
lime & shale	4020
lime	4547
chert, shale & lime	4580
lime	4848
chert	4873
lime & chert	4945
chert & shale	4955
shale & lime	4975
lime	5035
shale & chert	5065
lime & chert	5261
lime, chert & shale	5290
lime & chert	5450
Total Depth	
TOPS: LOG	
Stone Corral	2170
Chase	2688
Winfield	2732
Council Grove	2944
Adaire	3179
Wabaunsee	3354
Shawnee	3624
Heebner	3886
Lansing	3944
Kansas City	4164
Marmaton	4374
Cherokee	4439
St. Genevieve	4606
St. Louis	4650
Spergeon	4900
Warsaw	4978
Osage	5052
Kinderhook	5166
Viola	5329
Arbuckle	5401