

WELL PLUGGING RECORD

Give All Information Completely  
Make Required Affidavit  
Mail or Deliver Report to:  
Conservation Division  
State Corporation Commission  
212 No. Market  
Wichita, Kansas

Stafford County, Sec. 18 Twp. 25S Rge. 12 (E) W (W)

Location as "NE/CNWxSWx" or footage from lines C SE SE

Lease Owner Petroleum, Inc.

Lease Name Wilson T Well No. #1

Office Address R. R. #2 Great Bend, Kansas 67530

Character of Well (completed as Oil, Gas or Dry Hole)

Date well completed 19

Application for plugging filed June 3 19 69

Application for plugging approved June 6 19 69


Plugging commenced June 19 19 69

Plugging completed June 22 19 69

Reason for abandonment of well or producing formation

If a producing well is abandoned, date of last production 19

Was permission obtained from the Conservation Division or its agents before plugging was commenced? Yes

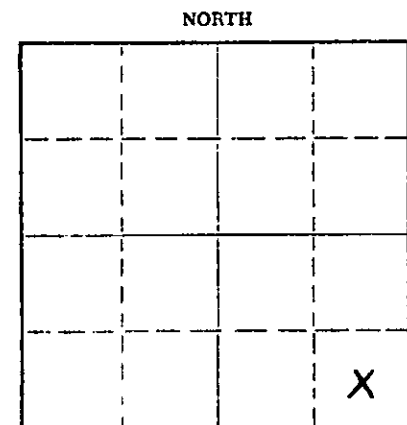

Locate well correctly on above Section Plat

Name of Conservation Agent who supervised plugging of this well Ralph Warren

Producing formation Depth to top Bottom Total Depth of Well Feet

Show depth and thickness of all water, oil and gas formations.

OIL, GAS OR WATER RECORDS

CASING RECORD

| FORMATION | CONTENT | FROM | TO | SIZE  | PUT IN | PULLED OUT |
|-----------|---------|------|----|-------|--------|------------|
|           |         |      |    | 8 5/8 | 292    | None       |
|           |         |      |    | 5 1/2 | 4250   | 2105       |
|           |         |      |    |       |        |            |
|           |         |      |    |       |        |            |
Describe in detail the manner in which the well was plugged, indicating where the mud fluid was placed and the method or methods used in introducing it into the hole. If cement or other plugs were used, state the character of same and depth placed, from feet to feet for each plug set.

6 - 19 - 69 Dumped sand to 3910'. Mixed and dumped 5 sx of cement to 3870'

6 - 22 - 69 Mixed and pumped 10 sx of gel down surface casing. Mixed and pumped 75 sx of cement down surface casing.

RECEIVED  
STATE CORPORATION COMMISSION  
JUN 30 1969  
CONSERVATION DIVISION  
Wichita, Kansas

(If additional description is necessary, use BACK of this sheet)

Name of Plugging Contractor Russ Casing Pulling, Inc.

Address P. O. Box 1082, Great Bend, Kansas 67530

STATE OF Oklahoma, COUNTY OF Creek, ss. T. P. McAdams, Jr.

(employee of owner) or (owner or operator) of the above-described well, being first duly sworn on oath, says: That I have knowledge of the facts, statements, and matters herein contained and the log of the above-described well as filed and that the same are true and correct. So help me God. McAdams Pipe & Supply Co.

(Signature) [Signature] P O Box 960, Bristow, Oklahoma (Address)

SUBSCRIBED AND SWORN TO before me this 28th day of June, 19 69

My commission expires May 12, 1973

Notary Public.

15-185-01181-00-00  
WELL LOG

COMPANY **PETROLEUM, INCORPORATED**

BED. 18 T. 25S R. 14W

FARM **WILSON "T" NO. 1**

LOC. Approx. C-SE, SE


TOTAL DEPTH **4437'**

COUNTY **STAFFORD CO., KANSAS**

COMM. **May 28, 1961**

COMP. **June 9, 1961**

CONTRACTOR **GARVEY DRILLING COMPANY**

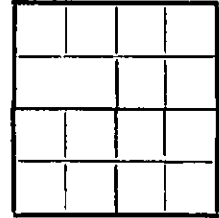

CASING **8-5/8" @ 292' w/225 sax.  
5 1/2" @ 4250' w/200 sax.**

ELEVATION **1986' DF**

PRODUCTION **Kansas City**

FIGURES INDICATE BOTTOM OF FORMATIONS

|      |                     |
|------|---------------------|
| 225  | Sand, clay & gravel |
| 260  | Shale               |
| 790  | Red bed             |
| 920  | Sand                |
| 940  | Anhydrite           |
| 1800 | Red bed & shale     |
| 1900 | Shale               |
| 2210 | Broken lime & shale |
| 2400 | Lime                |
| 3195 | Lime & shale        |
| 3500 | Shale & lime        |
| 3640 | Lime                |
| 3760 | Shale & lime        |
| 4160 | Lime                |
| 4185 | Chert & shale       |
| 4208 | Shale               |
| 4285 | Lime                |
| 4328 | Lime & chert        |
| 4437 | Lime                |
| 4437 | T. D.               |

RECEIVED  
STATE CORPORATION COMMISSION  
JUN 6 1969  
CONSERVATION DIVISION  
Wichita, Kansas

State of KANSAS  
County of BARTON } ss

I, VERNE A. MORRIS of GARVEY DRILLING COMPANY

upon oath state the above and foregoing is a true and correct copy of the log of the #1 WILSON "T" well.

*Verne A. Morris*

Subscribed and sworn to before me this 6th day of July 19 61

My Commission Expires: April 14, 1963

*Arthur J. Miles*  
NOTARY PUBLIC