


STATE OF KANSAS
STATE CORPORATION COMMISSION

15-171-20105-0000

WELL PLUGGING RECORD

Give All Information Completely
Make Required Affidavit
Mail or Deliver Report to
Conservation Division
State Corporation Comm.
245 North Water
Wichita, KS 67202

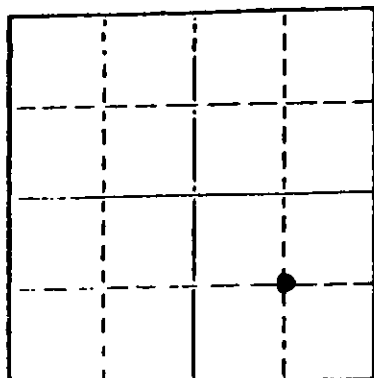

Locate well correctly on above Section Plot

Scott County. Sec. 23 Twp. 18 Rge. 32 N/W
Location as "NE/CNW $\frac{1}{4}$ SW $\frac{1}{4}$ " or footage from lines C SE 1/4
Lease Owner Car-Ren Inc.
Lease Name Beckley Well No. 1-23
Office Address 645 Garvey Bldg., Wichita, Kans.
Character of Well (Completed as Oil, Gas or Dry Hole) Gas
Date Well completed 19
Application for plugging filed Jan. 10, 1977
Application for plugging approved Jan. 11, 1977
Plugging commenced Jan. 17, 1977
Plugging completed Jan. 20, 1977
Reason for abandonment of well or producing formation Non Comercial Value
If a producing well is abandoned, date of last production None 19
Was permission obtained from the Conservation Division or its agents before plugging was commenced? Yes

Name of Conservation Agent who supervised plugging of this well Mr. Balthazor
Producing formation Hugoton Depth to top 2781 Bottom 2788 Total Depth of Well 2835'
Show depth and thickness of all water, oil and gas formations.

OIL, GAS OR WATER RECORDS

CASING RECORD

FORMATION	CONTENT	FROM	TO	SIZE	PUT IN	PULLED OUT
Surface		0'	35 1/2'	8 5/8"	35 1/2'	0'
Hugoton		0'	2831'	4 1/2"	2831'	1432'

Describe in detail the manner in which the well was plugged, indicating where the mud fluid was placed and the method or methods used in introducing it into the hold. If cement or other plugs were used, state the character of same and depth placed, from _____ feet to _____ feet for each plug set.

Pumped 1 sack hulls & 10 sacks cement to 2585' - Pressured to 500 lbs.
Mud 2585' to 1000'
Pumped 25 sacks cement 1000' to 920'
Displaced w/ 10 sacks gel & follow w/ 25 sacks cement 350' **RECEIVED**
Displaced w/ 5 sacks gel & followed w/ 10 sacks cement. **STATE CORPORATION COMMISSION**
Finished w/ 250 lbs pressure.
Cut off 8 5/8" 42" below ground level.

JAN 27 1977
1-27-77
CONSERVATION DIVISION
Wichita, Kansas

(If additional description is necessary, use BACK of this sheet)

Name of Plugging Contractor Midwest Casing Pulling
Box F, Sublette, Kansas Ks. Permit # 766

STATE OF ~~KANSAS~~ Kansas COUNTY OF Haskell, ss.
I Edgar J. Eves (employee of owner) or (owner or operator)
of the above-described well, being first duly sworn on oath, says: That I have knowledge of the facts, statements, and matters herein contained and the log of the above-described well as filed and that the same are true and correct. So help me God.

(Signature) Edgar J. Eves
Box F, Sublette, Kansas 67877
(Address)

SUBSCRIBED AND SWORN TO before me this 21st day of January, 1977

Sandra L. Eves
Notary Public.

My commission expires Dec. 6, 1980



DRILLERS LOG

OPERATOR Car-Ren, Inc.
 Suite 645 R. H. Garvey Building
 Wichita, Kansas 67202

LEASE NAME Beckley #1-23
 C SE/4 Sec. 23-18S-32W
 Scott County, Kansas

CONTRACTOR Slawson Drilling Company, Inc.
 408 One Twenty Building
 Wichita, Kansas 67202

COMMENCED: October 2, 1976

COMPLETED: October 6, 1976

SURFACE 345.83' set at 354' of used 8-5/8" with 275 sx cement

TOTAL DEPTH 2835'

0' to 357' 12 1/2" surface hole
 357' to 1634' Shale
 1634' to 2305' Shale & Shells
 2305' to 2320' Anhydrite
 2320' to 2751' Shale & Shells
 2751' to 2805' Lime
 2805' to 2835' Shale & Lime
 2835' RTD

4 1/2" casing run 2830.55' with 100 sx cement

RECEIVED
STATE CORPORATION COMMISSION

JAN 10 1977

CONSERVATION DIVISION
Wichita, Kansas

STATE OF KANSAS
COUNTY OF SEDGWICK

I, Rene Stucky, of the Slawson Drilling Company, Inc. upon oath state that the above and foregoing is a true and correct copy of the log of the Beckley #1-23 well.

Rene Stucky
 Rene Stucky, Engineering Assistant

Subscribed and sworn to me on October 16, 1976

Mary Lou Taylor
 Mary Lou Taylor, Notary

My commission expires January 17, 1977

