

STATE CORPORATION COMMISSION OF KANSAS  
OIL & GAS CONSERVATION DIVISION

WELL COMPLETION OR RECOMPLETION FORM  
ACO-1 WELL HISTORY

DESCRIPTION OF WELL AND LEASE

Operator: License # 5210  
Name Lebsack Oil Production  
Address Box 489  
City/State/Zip Hays, KS 67601

Purchaser Inland Crude Purchasing

Operator Contact Person Rex Curtis  
Phone 913-625-3046

Contractor: License # 5210  
Name Abercrombie Drilling, Inc.

Wellsite Geologist Wayne Lebsack  
Phone 316-938-2396

Designate Type of Completion  
 New Well  Re-Entry  Workover

Oil  SWD  Temp Abd  
 Gas  Inj  Delayed Comp.  
 Dry  Other (Core, Water Supply, etc.)

If OWWO: old well info as follows:  
Operator  
Well Name  
Comp. Date Old Total Depth

API NO. 15-171-20,293-0000

County Scott

SE SW Sec 5 Twp 20S Rge 33  East  West

660 Ft North from Southeast Corner of Section  
3300 Ft West from Southeast Corner of Section  
(Note: Locate well in section plat below)


Lease Name Hattendorf "B" Well # 1

Field Name Rothfelder North

Producing Formation Morrow

Elevation: Ground 2981' KB 2986'

Section Plat

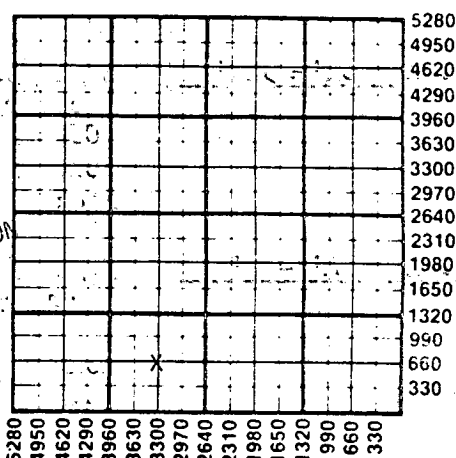

WATER SUPPLY INFORMATION

Disposition of Produced Water:  Disposal  Repressuring  
Docket #

WELL HISTORY

Drilling Method:  Mud Rotary  Air Rotary  Cable

4/23/85 5/01/85 6-1-85  
Spud Date Date Reached TD Completion Date

4800' PBDT  
Total Depth

Amount of Surface Pipe Set and Cemented at 428' feet  
Multiple Stage Cementing Collar Used?  Yes  No

If yes, show depth set 2003' feet  
If alternate 2 completion, cement circulated from 2003' feet depth to 1675' w/ 150 SX cmt

Questions on this portion of the ACO-1 call:  
Water Resources Board (913) 296-3717

Source of Water:  
Division of Water Resources Permit #

Groundwater 5270' Ft North from Southeast Corner  
(Well) 2805' Ft West from Southeast Corner of  
Sec 5 Twp 20S Rge 33  East  West

Surface Water ..... Ft North from Southeast Corner  
(Stream, pond etc) ..... Ft West from Southeast Corner  
Sec Twp Rge  East  West


Other (explain) .....  
(purchased from city, R.W.D. #)

INSTRUCTIONS: This form shall be completed in duplicate and filed with the Kansas Corporation Commission, 200 Colorado Derby Building, Wichita, Kansas 67202, within 90 days after completion or recompletion of any well. Rule 82-3-130 and 82-3-107 apply. Information on side two of this form will be held confidential for a period of 12 months if requested in writing and submitted with the form. See rule 82-3-107 for confidentiality in excess of 12 months. One copy of all wireline logs and drillers time log shall be attached with this form. Submit CP-4 form with all plugged wells. Submit CP-111 form with all temporarily abandoned wells.

All requirements of the statutes, rules and regulations promulgated to regulate the oil and gas industry have been fully complied with and the statements herein are complete and correct to the best of my knowledge.

Signature Marjorie Curtis  
Title VP Date 6/17/85

Subscribed and sworn to before me this 17th day of June 1985  
Notary Public D. Rex Curtis  
Date Commission Expires 7/28/85

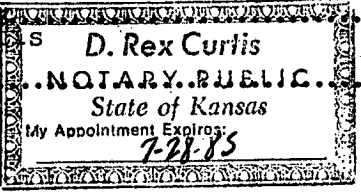

K.C.C. OFFICE USE ONLY  
F  Letter of Confidentiality Attached  
C  Wireline Log Received  
C  Drillers Timelog Received  
Distribution  
 KCC  SWD/Rep  NGPA  
 KGS  Plug  Other (Specify)

Sec 5 Twp 20S Rge 33W

SIDE TWO

Operator Name Lebsack Oil Production Lease Name HATTENDORF "B" Well # 1

Sec 5 Twp 20S Rge 33  East  West County Scott

WELL LOG

INSTRUCTIONS: Show important tops and base of formations penetrated. Detail all cores. Report all drill stem tests giving interval tested, time tool open and closed, flowing and shut-in pressures, whether shut-in pressure reached static level, hydrostatic pressures, bottom hole temperature, fluid recovery, and flow rates if gas to surface during test. Attach extra sheet if more space is needed. Attach copy of log.

Drill Stem Tests Taken	<input checked="" type="checkbox"/> Yes	<input type="checkbox"/> No	Formation Description <input checked="" type="checkbox"/> Log <input type="checkbox"/> Sample
Samples Sent to Geological Survey	<input type="checkbox"/> Yes	<input type="checkbox"/> No	
Cores Taken	<input type="checkbox"/> Yes	<input type="checkbox"/> No	

DST NO.	Interval	30/30/30/30	Recovery	ICIP	FCIP	FP	Name	Top	Bottom
<u>1</u>	<u>4461'-4510'</u>		<u>30'</u> Mud	<u>178</u>	<u>104</u>	<u>44/44 &amp; 59/59</u>	Heebner	<u>3856</u>	
							Lansing	<u>3902</u>	
							Base of K.C.	<u>4355</u>	
							Marmaton	<u>4380</u>	
							Cherokee	<u>4517</u>	
							Morrow Shale	<u>4657</u>	
							Morrow Sand	<u>4680</u>	
							Mississippi	<u>4696</u>	
<u>2</u>	<u>4654'-70'</u>		<u>128'</u> HO	<u>939</u>	<u>913</u>	<u>44/117 &amp; 134/180</u>			

CASING RECORD <input checked="" type="checkbox"/> New <input checked="" type="checkbox"/> Used Report all strings set-conductor, surface, intermediate, production, etc.							
Purpose of String	Size Hole Drilled	Size Casing Set (in O.D.)	Weight Lbs/Ft.	Setting Depth	Type of Cement	#Sacks Used	Type and Percent Additives
Surface	12 1/2"	8 5/8"	20#	428.80'	Hall Lt.	150	3% C.C.
					Type H	150	3% C.C.
Production	7 7/8"	5 1/2"	14#	4799'	60-40 poz.	180	2% gel, 15% Salt
PERFORATION RECORD				Acid, Fracture, Shot, Cement Squeeze Record			
Shots Per Foot	Specify Footage of Each Interval Perforated			(Amount and Kind of Material Used)		Depth	
<u>2</u>	<u>4682-92</u>			<u>1000/gal. diesel</u>			
				<u>Frac. w/360 barrels gelled</u>			
				<u>diesel - 135 sax 20/40 sand</u>			
				<u>and 75 sax 12/20 sand</u>			
TUBING RECORD				Liner Run <input type="checkbox"/> Yes <input type="checkbox"/> No			
Date of First Production		Producing Method					
<u>6/1/85</u>		<input type="checkbox"/> Flowing <input checked="" type="checkbox"/> Pumping <input type="checkbox"/> Gas Lift <input type="checkbox"/> Other (explain)					
Estimated Production Per 24 Hours	Oil	Gas	Water	Gas-Oil Ratio	Gravity		
	<u>20</u> Bbls	<u>MCF</u>	<u>15</u> Bbls	<u>CFPB</u>	<u>28</u>		

METHOD OF COMPLETION

Disposition of gas:  Vented  Sold  Used on Lease

Open Hole  Perforation  
 Other (Specify) .....  
 Dually Completed .....  
 Commingled .....

Production Interval