

STATE CORPORATION COMMISSION OF KANSAS
OIL & GAS CONSERVATION DIVISION
WELL COMPLETION OR RECOMPLETION FORM
ACO-1 WELL HISTORY
DESCRIPTION OF WELL AND LEASE

Operator: License # 8541
Name Petex, Inc.
Address Route 2, Box 553
Rogersville, MO 65742

Purchaser.....

Operator Contact Person Larry Childress
Phone 417-887-6289

Contractor: License # 9087
Name R. & C. Drilling, Inc.

Wellsite Geologist Steve Marden
Phone.....

Designate Type of Completion
 New Well Re-Entry Workover
 Oil SWD Temp Abd
 Gas Inj Delayed Comp.
 Dry Other (Core, Water Supply etc.)

If OWWO: old well info as follows:
Operator.....
Well Name.....
Comp. Date.....Old Total Depth.....

WELL HISTORY

Drilling Method:
 Mud Rotary Air Rotary Cable

4-22-86 5-2-86 5-2-86
Spud Date Date Reached TD Completion Date
4770
Total Depth PBSD

Amount of Surface Pipe Set and Cemented at 208 feet
Multiple Stage Cementing Collar Used? Yes No
If yes, show depth set.....feet
If alternate 2 completion, cement circulated
from.....feet depth to.....w/.....
Cement Company Name.....
Invoice #.....

API NO. 15-.....109-20-418-00-00
County Jogon
SE.. SE... NW... Sec. 21.. Twp. 12.. Rge. 33.. East
X West

2970..... Ft North from Southeast Corner of Section
2970..... Ft West from Southeast Corner of Section
(Note: Locate well in section plat below)


Lease Name Ahrens.....Well # 2..

Field Name.....

Producing Formation.....

Elevation: Ground.....3130.....KB.....3135.....

Section Plat

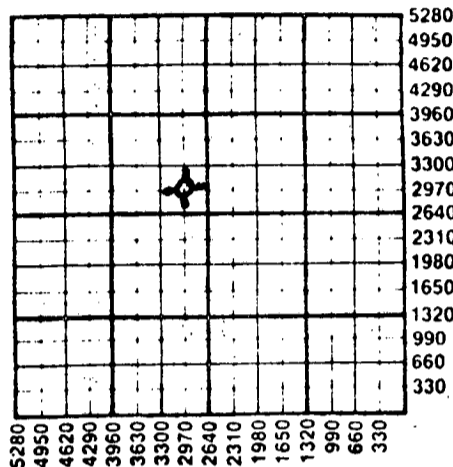

WATER SUPPLY INFORMATION

Disposition of Produced Water: Disposal
Docket #..... Repressuring

Questions on this portion of the ACO-1 call:
Water Resources Board (913) 296-3717

Source of Water: Kenneth Uhrich (water well)
Division of Water Resources Permit #.....
Oakley, Kansas

Groundwater.....Ft North from Southeast Corner
(Well).....Ft West from Southeast Corner of
Sec Twp Rge East West

Surface Water.....Ft North from Southeast Corner
(Stream, pond etc).....Ft West from Southeast Corner
Sec Twp Rge East West

Other (explain).....
(purchased from city, R.W.D. #)

INSTRUCTIONS: This form shall be completed in accordance with the Kansas Corporation Commission, 200 Colorado Derby Building, Wichita, Kansas 67202, within 90 days after completion or recompletion of any well. Rule 82-3-130 and 82-3-107 apply.
Information on side two of this form will be held confidential for a period of 12 months if requested in writing and submitted with the form. See rule 82-3-107 for confidentiality in excess of 12 months.
One copy of all wireline logs and drillers time log shall be attached with this form. Submit CP-4 form with all plugged wells. Submit CP-111 form with all temporarily abandoned wells.

All requirements of the statutes, rules and regulations promulgated to regulate the oil and gas industry have been fully complied with and the statements herein are complete and correct to the best of my knowledge.

Signature Larry Childress
Title President

Date June 10, 1986

Subscribed and sworn to before me this 10 day of June
1986

Notary Public Peggy Steelman

Date Commission Expires 7/29/87

K.C.C. OFFICE USE ONLY
 Letter of Confidentiality Attached
 Wireline Log Received
 Drillers Timelog Received
Distribution
 KCC SWD/Rep NGPA
 KGS Plug Other
(Specify)

Section 1, Twp. 12, Rge. 33