

15-199-20212-0000

FORM C-1 7/91  
FORM MUST BE TYPED  
FORM MUST BE SIGNED  
ALL BLANKS MUST BE FILLED

EFFECTIVE DATE: 12-15-93  
DISTRICT # 4  
SGA? Yes No

State of Kansas  
NOTICE OF INTENTION TO DRILL

Must be approved by the K.C.C. five (5) days prior to commencing well

Expected Spud Date 12 11 93  
month day year

Spot 125' W C E/2 Sec 30 Twp 15 S Rg 41 East West

OPERATOR: License # 30606  
Name: MURFIN DRILLING COMPANY, INC.  
Address: 250 N. Water, Suite 300  
City/State/Zip: Wichita, Ks. 67202  
Contact Person: Scott Robinson  
Phone: 316-267-3241

2640 feet from South North line of Section  
1445 feet from East West line of Section  
IS SECTION X REGULAR IRREGULAR?

CONTRACTOR: License # 30606  
Name: Murfin Drilling Company, Inc.

(NOTE: Locate well on the Section Plat on Reverse Side)  
County: Wallace  
Lease Name: GOSHBAGR Well #: 1-30  
Field Name: wildcat

Well Drilled For: Well Class: Type Equipment:  
X Oil ... Enh Rec ... Infield X Mud Rotary  
... Gas ... Storage ... Pool Ext. ... Air Rotary  
... OWWO ... Disposal X Wildcat ... Cable  
... Seismic: ... # of Holes ... Other  
... Other

Is this a Prorated/Spaced Field? ... yes X no  
Target Formation(s): Morrow  
Nearest lease or unit boundary: 1445

If OWWO: old well information as follows:  
Operator:  
Well Name:  
Comp. Date: Old Total Depth

Ground Surface Elevation: 3801 est foot MSL  
Water well within one-quarter mile: ... yes X no  
Public water supply well within one mile: ... yes X no

Directional, Deviated or Horizontal wellbore? ... yes X no  
If yes, true vertical depth:  
Bottom Hole Location

Depth to bottom of fresh water: 150'  
Depth to bottom of usable water: 1600'  
Surface Pipe by Alternate: 1 X 2

Length of Surface Pipe Planned to be set: 350'  
Length of Conductor pipe required: N/A  
Projected Total Depth: 5300'

Formation at Total Depth: Mississippian  
Water Source for Drilling Operations:  
... well ... farm pond X other

DWR Permit #:  
Will Cores Be Taken?: ... yes ... no  
If yes, proposed zone:

AFFIDAVIT

The undersigned hereby affirms that the drilling, completion and eventual plugging of this well will comply with K.S.A. 55-101, et. seq.  
It is agreed that the following minimum requirements will be met:

- 1. Notify the appropriate district office prior to spudding of well;
- 2. A copy of the approved notice of intent to drill shall be posted on each drilling rig;
- 3. The minimum amount of surface pipe as specified below shall be set by circulating cement to the top; in all cases surface pipe shall be set through all unconsolidated materials plus a minimum of 20 feet into the underlying formation;
- 4. If the well is dry hole, an agreement between the operator and the district office on plug length and placement is necessary prior to plugging;
- 5. The appropriate district office will be notified before well is either plugged or production casing is cemented in;
- 6. IF AN ALTERNATE II COMPLETION, PRODUCTION PIPE SHALL BE CEMENTED FROM BELOW ANY USABLE WATER TO SURFACE WITHIN 120 DAYS OF SPUD DATE. IN ALL CASES, NOTIFY DISTRICT OFFICE PRIOR TO ANY CEMENTING.

I hereby certify that the statements made herein are true and to the best of my knowledge and belief.  
Date: 12/10/93 Signature of Operator or Agent: Scott Robinson Title: Geological Manager

FOR KCC USE:  
API # 15- 199-20212-00-00  
Conductor pipe required None feet  
Minimum surface pipe required 350' feet per Alt. X  
Approved by: CB 12-10-93  
This authorization expires: 6-10-94  
(This authorization void if drilling not started within 6 months of effective date.)  
Spud date: Agent:

30  
15  
41  
RWD  
12-10-93

REMEMBER TO:

- File Drill Pit Application (form CDP-1) with Intent to Drill;
- File Completion Form ACO-1 within 120 days of spud date;
- File acreage attribution plat according to field proration orders;
- Notify appropriate district office 48 hours prior to workover or re-entry;
- Submit plugging report (CP-4) after plugging is completed;
- Obtain written approval before disposing or injecting salt water.

Mail to: Conservation Division, 200 Colorado Derby Building, 202 W. First St., Wichita, Kansas 67202-1286.

**IN ALL CASES PLOT THE INTENDED WELL ON THE PLAT BELOW**

**PLAT OF ACREAGE ATTRIBUTABLE TO A WELL IN A PRORATED OR SPACED FIELD**

If the intended well is in a prorated or spaced field, please fully complete this side of the form. If the intended well is in a prorated or spaced field complete the plat below showing that the well will be properly located in relationship to other wells producing from the common source of supply. Please show all the wells within 1 mile of the boundaries of the proposed acreage attribution unit for gas wells and within 1/2 mile of the boundaries of the proposed acreage attribution unit for oil wells.

API NO. 15- \_\_\_\_\_  
 OPERATOR MURFIN DRILLING COMPANY, INC.  
 LEASE GOSHBKR  
 WELL NUMBER #1-30  
 FIELD Wildcat

LOCATION OF WELL: COUNTY Wallace  
2640 feet from south north line of section  
1445 feet from east west line of section  
 SECTION 30 TWP 15 S RG 41 W



NUMBER OF ACRES ATTRIBUTABLE TO WELL \_\_\_\_\_  
 QTR/QTR/QTR OF ACREAGE \_\_\_\_\_

IS SECTION X REGULAR or \_\_\_\_\_ IRREGULAR  
IF SECTION IS IRREGULAR, LOCATE WELL FROM NEAREST CORNER BOUNDARY.

Section corner used: \_\_\_\_\_ NE \_\_\_\_\_ NW \_\_\_\_\_ SE \_\_\_\_\_ SW

**PLAT**

(Show location of the well and shade attributable acreage for prorated or spaced wells.)  
 (Show footage to the nearest lease or unit boundary line.)

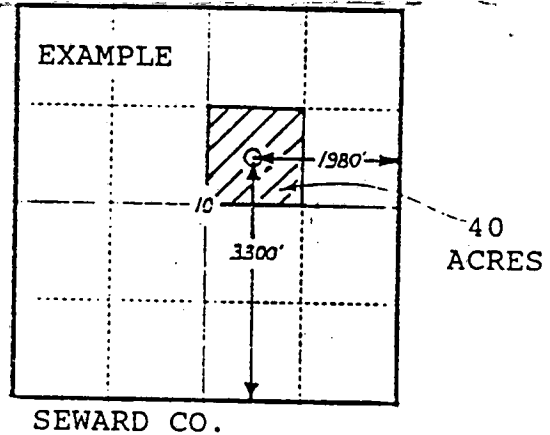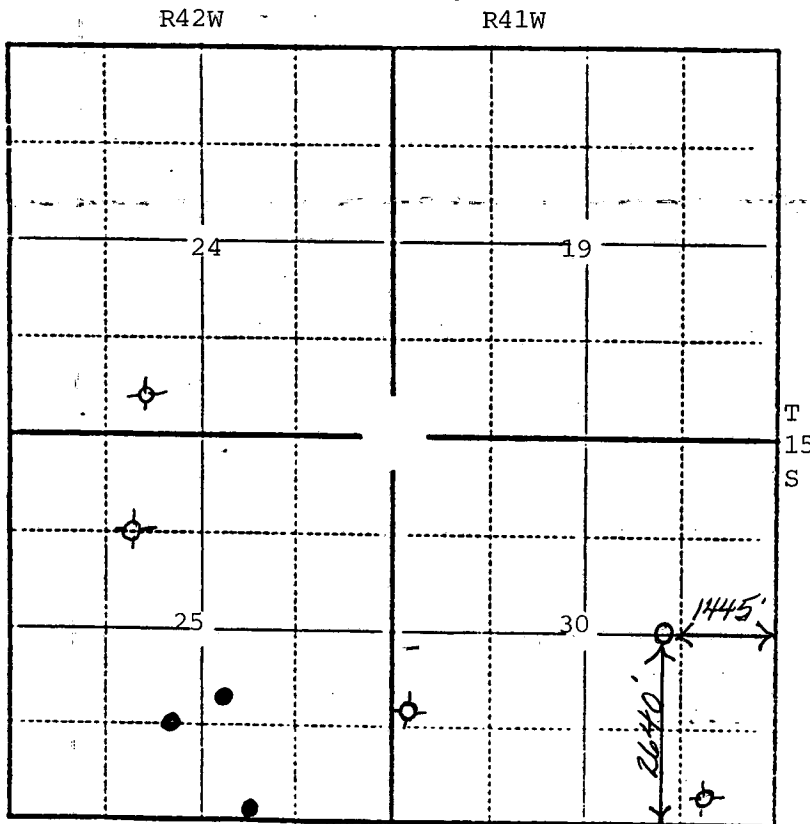

In plotting the proposed location of the well, you must show:

- 1) The manner in which you are using the depicted plat by identifying section lines, i.e. 1 section, 1 section with 8 surrounding sections, 4 sections, etc.;
- 2) the distance of the proposed drilling location from the section's south/north and east/west lines; and
- 3) the distance to the nearest lease or unit boundary line.