

CARD MUST BE TYPED

State of Kansas

CARD MUST BE SIGNED

NOTICE OF INTENTION TO DRILL

(see rules on reverse side)

Starting Date 01 02 88
month day year

API Number 15-199-20134-0000 ✓

OPERATOR: License # 8458

NE NE NW Sec. 30 Twp. 15 S, Rg. 42 X East
4950 Ft. from South Line of Section
2970 Ft. from East Line of Section

Name Transwestern Operating Company
Address P. O. Box 276
City/State/Zip Golden, CO 80202
Contact Person Doug Isern
Phone 303-279-2995

(Note: Locate well on Section Plat on reverse side)
Nearest lease or unit boundary line 330 feet
County Wallace

CONTRACTOR: License # 6033
Name Murfin Drilling Company
City/State Wichita, KS

Lease Name Welsh Well # 2-30
Ground surface elevation _____ feet MSL

Well Drilled For: Well Class: Type Equipment:
X Oil SWD Infield X Mud Rotary
Gas Inj Pool Ext. Air Rotary
OWWO Expl Wildcat Cable

Domestic well within 330 feet: yes X no
Municipal well within one mile: yes X no

If OWWO: old well info as follows:
Operator _____
Well Name _____
Comp Date _____ Old Total Depth _____

Depth to bottom of fresh water 275
Depth to bottom of usable water 1850
Surface pipe by Alternate: 1 2 X
Surface pipe planned to be set 380'
Conductor pipe required N/A
Projected Total Depth 5300' feet
Formation Morrow

I certify that well will comply with K.S.A. 55-101, et seq., plus eventually plugging hole to KCC specifications.
Date 12-23-87 Signature of Operator or Agent Rob Ramseyer, Agent for Operator Title Ass't. Drlg. Mgr.

For KCC Use:
Conductor Pipe Required _____ feet; Minimum Surface Pipe Required 360 feet per Alt. X (2)
This Authorization Expires 6-23-88 Approved By Rett 12-23-87


EFFECTIVE DATE: 12-28-87

Must be filed with the K.C.C. five (5) days prior to commencing well
This card void if drilling not started within six (6) months of date received by K.C.C.

Important procedures to follow:

1. Notify District office before setting surface casing.
2. Set surface casing by circulating cement to the top.
3. File completion forms ACO-1 with K.C.C. within 90 days of well completion, following instructions on ACO-1, side 1, and including copies of wireline logs.
4. Notify District office 48 hours prior to old well workover or re-entry.
5. Prior to filing Intent, prepare a proposed plugging plan in case well is D & A, then obtain approval of plan when calling district office prior to setting surface pipe.
6. Submit plugging report (CP-4) to K.C.C. after plugging is completed.
7. Obtain an approved injection docket number before disposing of salt water.
8. Notify K.C.C. within 10 days when injection commences or terminates.
9. If an alternate 2 completion, cement in the production pipe from below any usable water to surface within 120 days of spud date.

**A Regular Section of Land
1 Mile = 5,280 Ft.**

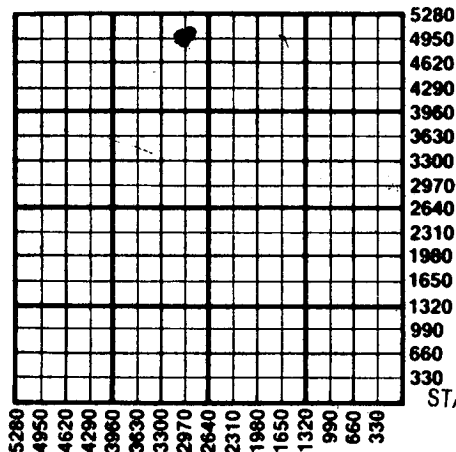

RECEIVED
STATE CORPORATION COMMISSION

DEC 23 1987

CONSERVATION DIVISION
Wichita, Kansas

State Corporation Commission of Kansas
Conservation Division
200 Colorado Derby Building
Wichita, Kansas 67202
(316) 263-3238