

CARD MUST BE TYPED

State of Kansas

CARD MUST BE SIGNED

NOTICE OF INTENTION TO DRILL

(see rules on reverse side)

AMENDED

✓ 10*

Expected Spud Date... 12-22-87
month day year

API Number 15- 199-20,125-00-00

OPERATOR: License # 8458
Name Transwestern Operating Company
Address P.O. Box 276
City/State/Zip Golden, CO 80202
Contact Person Doug Isern
Phone 303-279-2995

NW NW. NW. Sec. 30. Twp. 15. S, Rg. 42 East
 West
4950 Ft. from South Line of Section
 4950 Ft. from East Line of Section

(Note: Locate well on Section Plat on reverse side)

CONTRACTOR: License # 6033
Name Murfin Drilling Company
City/State Wichita, Ks. 67202

Nearest lease or unit boundary line 330 feet
County Wallace

Well Drilled For: Well Class: Type Equipment:
 Oil Storage Infield Mud Rotary
 Gas Inj Pool Ext. Air Rotary
 OWWO Expl Wildcat Cable

Lease Name WELSH Well # 1-30
Ground surface elevation TBD feet MSL
Domestic well within 330 feet: yes no
Municipal well within one mile: yes no
Depth to bottom of fresh water 275
Depth to bottom of usable water 1850
Surface pipe by Alternate: 1 2 X

If OWWO: old well info as follows:

Surface pipe planned to be set 380'
Conductor pipe required none
Projected Total Depth 5300' feet
Formation MORROW

Operator
Well Name
Comp Date Old Total Depth

I certify that well will comply with K.S.A. 55-101, et seq., plus or actually plugging hole to KCC specifications.

Date 12-8-87 Signature of Operator or Agent Rob Ramsey Title Agent for the Operator

For KCC Use:

Conductor Pipe Required _____ feet; Minimum Surface Pipe Required 300 feet per Alt. 2
This Authorization Expires 6-3-88 Approved By Fit 12-3-87


*WAS: NE-NE-NW 2970' FEL

12-11-87

Must be filed with the K.C.C. five (5) days prior to commencing well
This card void if drilling not started within six (6) months of date received by K.C.C.

Important procedures to follow:

A Regular Section of Land
1 Mile = 5,280 Ft.

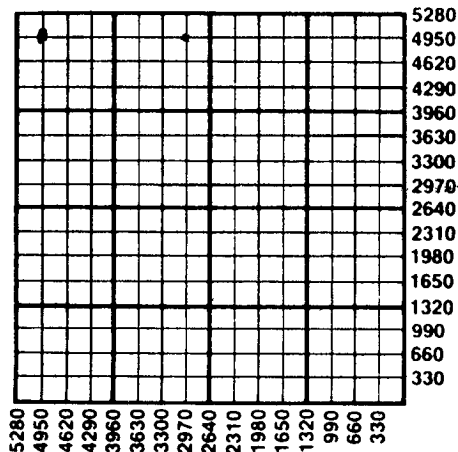

1. Notify District office before setting surface casing.
2. Set surface casing by circulating cement to the top.
3. File completion forms ACO-1 with K.C.C. within 120 days of well spud date, following instructions on ACO-1, side 1, and including copies of wireline logs.
4. Notify District office 48 hours prior to old well workover or re-entry.
5. Prior to filing Intent, prepare a proposed plugging plan in case well is D & A, then obtain approval of plan when calling district office prior to setting surface pipe.
6. Submit plugging report (CP-4) to K.C.C. after plugging is completed.
7. Obtain an approved injection docket number before disposing of salt water.
8. Notify K.C.C. within 10 days when injection commences or terminates.
9. If an alternate 2 completion, cement in the production pipe from below any usable water to surface within 120 days of spud date.

RECEIVED
STATE CORPORATION COMMISSION
DEC 10 1987
CONSERVATION DIVISION
Wichita, Kansas

12-10-87

State Corporation Commission of Kansas
Conservation Division
200 Colorado Derby Building
Wichita, Kansas 67202-1212
(316) 263-3238