

NOTICE OF INTENTION TO DRILL

(see rules on reverse side)

Second stage will be cemented w/in

120 days of spud date. 10 15 85
Starting Date month day year

OPERATOR: License # 5171
Name TXO Production Corp.
Address 1800 Lincoln Center Bldg.
City/State/Zip Denver, CO 80264
Contact Person Frank D. Tsuru
Phone (303) 861-4246

CONTRACTOR: License #
Name
City/State

Well Drilled For: Well Class: Type Equipment:
[X] Oil SWD Infield [X] Mud Rotary
Gas Inj [X] Pool Ext Air Rotary
OWWO Expl Wildcat Cable

If OWWO: old well info as follows:

Operator
Well Name
Comp Date Old Total Depth

I certify that well will comply with K.S.A. 55-101, et seq., plus eventually plugging hole to KCC specifications.

Date 10/4/85 Signature of Operator or Agent Frank D. Tsuru Title Drlg. & Prod. Engineer.

For KCC Use:

Conductor Pipe Required feet; Minimum Surface Pipe Required feet per Alt. 2

This Authorization Expires 4-9-86 Approved By 10-9-85

API Number 15- 199-20,069-00-00

NW SW SE Sec. 32 Twp. 15 S, Rg. 42
990 Ft. from South Line of Section
2310 Ft. from East Line of Section

(Note: Locate well on Section Plat on reverse side)

Nearest lease or unit boundary line 330 feet

County Wallace

Lease Name Wetig Well # 2

Ground surface elevation TBD feet MSL

Domestic well within 330 feet: yes [X] no

Municipal well within one mile: yes [X] no

Surface pipe by Alternate: 1 [X] 2 []

Depth to bottom of fresh water 300'

Depth to bottom of usable water 1700'

Surface pipe planned to be set 350'

Projected Total Depth 5300' feet


Formation Morrow-Mississippian

Must be filed with the K.C.C. five (5) days prior to commencing well
This card void if drilling not started within six (6) months of date received by K.C.C.

Important procedures to follow:

1. Notify District office before setting surface casing.
2. Set surface casing by circulating cement to the top.
3. File completion forms ACO-1 with K.C.C. within 90 days of well completion, following instructions on ACO-1, side 1, and including copies of wireline logs.
4. Notify District office 48 hours prior to old well workover or re-entry.
5. Prior to filing Intent, prepare a proposed plugging plan in case well is D & A, then obtain approval of plan when calling district office prior to setting surface pipe.
6. Submit plugging report (CP-4) to K.C.C. after plugging is completed.
7. Obtain an approved injection docket number before disposing of salt water.
8. Notify K.C.C. within 10 days when injection commences or terminates.

A Regular Section of Land
1 Mile = 5,280 Ft.

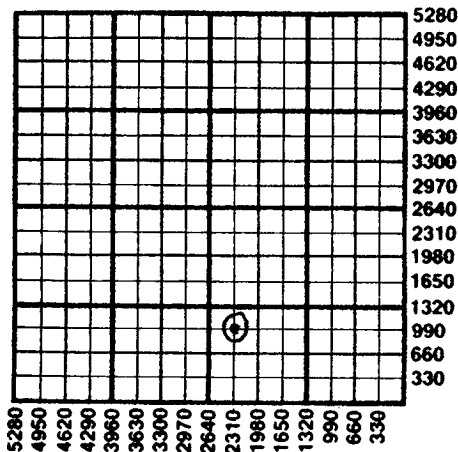

RECEIVED. If an alternate 2 completion, cement in the production pipe from
STATE CORPORATION COMMISSION any usable water to surface within 120 days of spud date.

OCT 9 1985
10-09-85
CONSERVATION DIVISION
Wichita, Kansas

State Corporation Commission of Kansas
Conservation Division
200 Colorado Derby Building
Wichita, Kansas 67202
(316) 263-3238