

CARD MUST BE TYPED

State of Kansas
NOTICE OF INTENTION TO DRILL

CARD MUST BE SIGNED

(see rules on reverse side)

Starting Date: 02 18 86
month day year 9:30

OPERATOR: License # 8458
Name Transwestern Operating Co.
Address 1615 California, Suite 704
City/State/Zip Denver, Colorado 80202
Contact Person Doug Isern
Phone (303) 825-1625

CONTRACTOR: License # 6033
Name Murfin Drilling Company
City/State Wichita, Kansas

Well Drilled For: Well Class: Type Equipment:

- Oil Swd Infield Mud Rotary
- Gas Inj Pool Ext. Air Rotary
- OWWO Expl Wildcat Cable

If OWWO: old well info as follows:

Operator
Well Name
Comp Date Old Total Depth
Projected Total Depth 5300 feet
Projected Formation at TD Miss.
Expected Producing Formations Morrow

API Number 15- 199-20,076-00-00

SW SE NE East
(location) Sec 32 Twp 15 S, Rge 42 West

2970 Ft North from Southeast Corner of Section
990 Ft West from Southeast Corner of Section
(Note: Locate well on Section Plat on reverse side)

Nearest lease or unit boundary line 990 feet.

County Wallace

Lease Name Bergquist Well# 2-32

Domestic well within 330 feet: yes no

Municipal well within one mile: yes no

Depth to Bottom of fresh water 150 feet

Lowest usable water formation Unconsolidated Dakota

Depth to Bottom of usable water 1850 feet

Surface pipe by Alternate: ~~14~~ 2 Alt. 2

Surface pipe to be set 380 feet

Conductor pipe if any required N/A feet

Ground surface elevation feet MSL

This Authorization Expires 8-18-86

Approved By 2-18-86

I certify that we will comply with K.S.A. 55-101, et seq., plus eventually plugging hole to K.C.C. specifications.

Date 02-18-86 Signature of Operator or Agent J.E. Goss, Agent for Opr. Title


Asst. Drilling Mgr. [Signature]

Must be filed with the K.C.C. five (5) days prior to commencing well
This card void if drilling not started within six (6) months of date received by K.C.C.

Important procedures to follow :

1. Notify District office before setting surface casing.
2. Set surface casing by circulating cement to the top.
3. File completion forms ACO-1 with K.C.C. within 90 days of well completion, following instructions on ACO-1, side 1, and including copies of wireline logs.
4. Notify District office 48 hours prior to old well workover or re-entry.
5. Prior to plugging, prepare a plugging plan, then obtain agreement from the appropriate district office for an approved plugging plan.
6. Submit plugging report (CP-4) to K.C.C. after plugging is completed.
7. Obtain an approved injection docket number before disposing of salt water.
8. Notify K.C.C. within 10 days when injection commences or terminates.
9. If an alternate 2 completion, cement in the production pipe from below usable water to surface within 120 days of spud date.

**A Regular Section of Land
1 Mile = 5,280 Ft.**

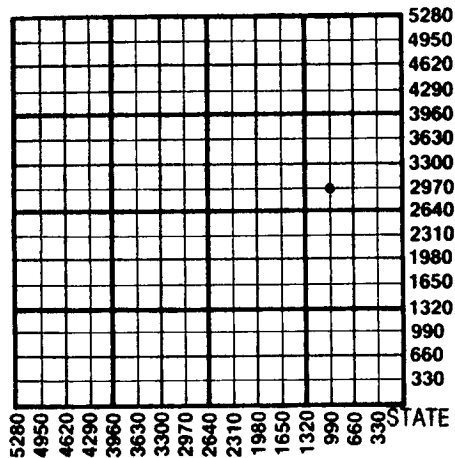

RECEIVED

STATE CORPORATION COMMISSION

FEB 18 1986

CONSERVATION DIVISION
Wichita, Kansas

State Corporation Commission of Kansas
Conservation Division
200 Colorado Derby Building
Wichita, Kansas 67202
(316) 263-3238