

CARD MUST BE TYPED

State of Kansas
NOTICE OF INTENTION TO DRILL

CARD MUST BE SIGNED

(see rules on reverse side)

Starting Date: August 21 1985
month day year

API Number 15- 199-20,061-00-00

OPERATOR: License # 5238
Name Petroleum, Inc.
Address 300 W. Douglas, Suite 800
City/State/Zip Wichita, KS 67202
Contact Person Steve Phillips
Phone (316) 624-1686

SE SW SW Sec 33 Twp 15 S, Rge 42 East
(location) West
330' Ft North from Southeast Corner of Section
4290' Ft West from Southeast Corner of Section
(Note: Locate well on Section Plat on reverse side)

CONTRACTOR: License # 5382
Name Cheyenne Drilling, Inc.
City/State P.O. Box 916, Garden City, KS 67846

Nearest lease or unit boundary line 330 feet.
County Wallace
Lease Name Smith 'BS' Well# 1
Domestic well within 330 feet: yes no
Municipal well within one mile: yes no

Well Drilled For: Well Class: Type Equipment:
 Oil Swd Infield Mud Rotary
 Gas Inj Pool Ext. Air Rotary
 OWWO Expl Wildcat Cable

Depth to Bottom of fresh water 270 feet
Lowest usable water formation Dakota
Depth to Bottom of usable water 170C feet
Surface pipe by Alternate: 1 2
Surface pipe to be set 1700 feet
Conductor pipe if any required - feet
Ground surface elevation - feet MSL
This Authorization Expires 2-19-86
Approved By RCH 8-19-85

If OWWO: old well info as follows:
Operator
Well Name
Comp Date Old Total Depth
Projected Total Depth 5250' feet
Projected Formation at TD Morrow
Expected Producing Formations Morrow

I certify that we will comply with K.S.A. 55-101, et seq., plus eventually plugging hole to K.C.C. specifications.

Date 8-20-85 Signature of Operator or Agent

Title Division Records Manager

Must be filed with the K.C.C. five (5) days prior to commencing well
 This card void if drilling not started within six (6) months of date received by K.C.C.


RECEIVED
 STATE CORPORATION COMMISSION

08-19-85
 AUG 19 1985

A Regular Section of Land
 1 Mile = 5,280 Ft.

CONSERVATION DIVISION

Wichita, Kansas

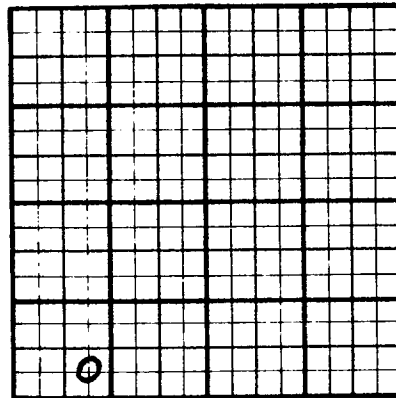

5280
 4950
 4620
 4290
 3960
 3630
 3300
 2970
 2640
 2310
 1980
 1650
 1320
 990
 660
 330

Important procedures to follow:

1. Notify District office before setting surface casing.
2. Set surface casing by circulating cement to the top.
3. File completion forms ACO-1 with K.C.C. within 90 days of well completion, following instructions on ACO-1, side 1, and including copies of wireline logs.
4. Notify District office 48 hours prior to old well workover or re-entry.
5. Prior to plugging, prepare a plugging plan, then obtain agreement from the appropriate district office for an approved plugging plan.
6. Submit plugging report (CP-4) to K.C.C. after plugging is completed.
7. Obtain an approved injection docket number before disposing of salt water.
8. Notify K.C.C. within 10 days when injection commences or terminates.
9. If an alternate 2 completion, cement in the production pipe from below any usable water to surface within 120 days of spud date.

State Corporation Commission of Kansas
 Conservation Division
 200 Colorado Derby Building
 Wichita, Kansas 67202
 (316) 263-3238