

NOTICE OF INTENTION TO DRILL

(see rules on reverse side)

Starting Date April 23 1986 month day year

4.21

OPERATOR: License # 5238 Name Petroleum, Inc. Address 300 W. Douglas City/State/Zip Wichita, KS 67202 Contact Person Steve Phillips Phone 316 624-1686

CONTRACTOR: License # 5382 Name Cheyenne Drilling, Inc. City/State P. O. Box 916, Garden City, KS 67846

Well Drilled For: Well Class: Type Equipment: X Oil SWD Infield X Mud Rotary Gas Inj Pool Ext Air Rotary OWWO Expl X Wildcat Cable

If OWWO: old well info as follows:

Operator Well Name Comp Date Old Total Depth

I certify that well will comply with K.S.A. 55-101, et seq., plus eventually plugging hole to KCC specifications.

cementing will be done immediately upon setting production casing.

Date 4-21-86 Signature of Operator or Agent [Signature] Title Records Manager

For KCC Use:

Conductor Pipe Required feet; Minimum Surface Pipe Required feet per Alt 19

This Authorization Expires 10-21-86 Approved By [Signature] 4-21-86

API Number 15- 199-20,084-00-00

SW NW SW Sec 33 Twp 15 S, Rg 42 West 1650 Ft. from South Line of Section 4950 Ft. from East Line of Section

(Note: Locate well on Section Plat on reverse side)

Nearest lease or unit boundary line 330 feet

County Wallace

Lease Name Smith 'BS' Well # 3

Ground surface elevation feet MSL

Domestic well within 330 feet: yes X no

Municipal well within one mile: yes X no

Surface pipe by Alternate: 1 X 2

Depth to bottom of fresh water 270

Depth to bottom of usable water 1700

Surface pipe planned to be set 1740

Projected Total Depth 5200 feet


Formation Morrow

Must be filed with the K.C.C. five (5) days prior to commencing well  
This card void if drilling not started within six (6) months of date received by K.C.C.

**Important procedures to follow:**

1. Notify District office before setting surface casing.
2. Set surface casing by circulating cement to the top.
3. File completion forms ACO-1 with K.C.C. within 90 days of well completion, following instructions on ACO-1, side 1, and including copies of wireline logs.
4. Notify District office 48 hours prior to old well workover or re-entry.
5. Prior to filing Intent, prepare a proposed plugging plan in case well is D & A, then obtain approval of plan when calling district office prior to setting surface pipe.
6. Submit plugging report (CP-4) to K.C.C. after plugging is completed.
7. Obtain an approved injection docket number before disposing of salt water.
8. Notify K.C.C. within 10 days when injection commences or terminates.
9. If an alternate 2 completion, cement in the production pipe from below any usable water to surface within 120 days of spud date.

**A Regular Section of Land**  
1 Mile = 5,280 Ft.

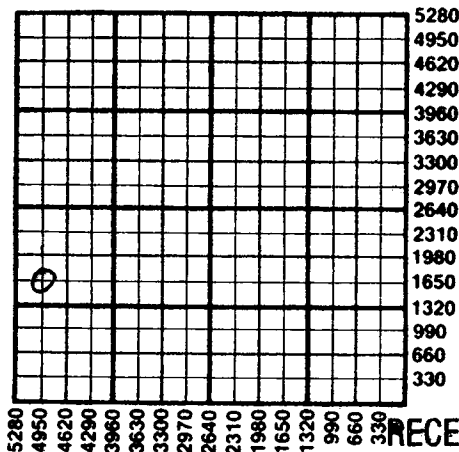

**RECEIVED**  
STATE CORPORATION COMMISSION

APR 21 1986  
04-21-86  
CONSERVATION DIVISION  
Wichita, Kansas

State Corporation Commission of Kansas  
Conservation Division  
200 Colorado Derby Building  
Wichita, Kansas 67202  
(316) 263-3238