

CARD MUST BE TYPED

State of Kansas

CORRECTED CARD MUST BE SIGNED

NOTICE OF INTENTION TO DRILL

(see rules on reverse side)

VO

Starting Date 05 10 88
month day year

API Number 15-199-20,152-00-00

OPERATOR: License # 5171

Nw Nw Sw
~~SE NE NE~~ Sec. 6 Twp. 15 S, Rg. 42 East

Name TXO Production Corp.

Address 1800 Lincoln Center Bldg.

City/State/Zip Denver, CO 80264

Contact Person Frank D. Tsuru

Phone 303-861-4246

2180 Ft. from South Line of Section

460 Ft. from East Line of Section

(Note: Locate well on Section Plat on reverse side)

CONTRACTOR: License # 6033

Name Murfin Drilling Company

City/State Wichita, KS

Nearest lease or unit boundary line .. 460 feet

County Wallace

Lease Name Hibbert "B" Well # 3

Ground surface elevation 3935' feet MSL

Domestic well within 330 feet: yes no

Municipal well within one mile: yes no

Well Drilled For: Well Class: Type Equipment:

Oil SWD Infield Mud Rotary

Gas Inj Pool Ext. Air Rotary

OWWO Expl Wildcat Cable

Depth to bottom of fresh water 350'

Depth to bottom of usable water 1800'

Surface pipe by Alternate: 1 2

If OWWO: old well info as follows:

Operator

Well Name

Comp Date Old Total Depth

Surface pipe planned to be set 650'

Conductor pipe required N/A

Projected Total Depth 5300' feet

Formation Morrow Sand

I certify that well will comply with K.S.A. 55-101, et seq., plus eventually plugging hole to KCC specifications.

Date 5-4-88 Signature of Operator or Agent

Title. Ass't. Drlg. Mgr.

Rob Ramseyer, Agent for Operator

For KCC Use:

Conductor Pipe Required feet; Minimum Surface Pipe Required 400 feet per Alt. 2

This Authorization Expires *11-4-88* Approved By *RLH 5-4-88 DW 7-07-89*


EFFECTIVE DATE: 5-9-88

Must be filed with the K.C.C. five (5) days prior to commencing well
This card void if drilling not started within six (6) months of date received by K.C.C.

Important procedures to follow:

1. Notify District office before setting surface casing.
2. Set surface casing by circulating cement to the top.
3. File completion forms ACO-1 with K.C.C. within 90 days of well completion, following instructions on ACO-1, side 1, and including copies of wireline logs.
4. Notify District office 48 hours prior to old well workover or re-entry.
5. Prior to filing Intent, prepare a proposed plugging plan in case well is D & A, then obtain approval of plan when calling district office prior to setting surface pipe.
6. Submit plugging report (CP-4) to K.C.C. after plugging is completed.
7. Obtain an approved injection docket number before disposing of salt water.
8. Notify K.C.C. within 10 days when injection commences or terminates.
9. If an alternate 2 completion, cement in the production pipe from below any usable water to surface within 120 days of spud date.

A Regular Section of Land 1 Mile = 5,280 Ft.

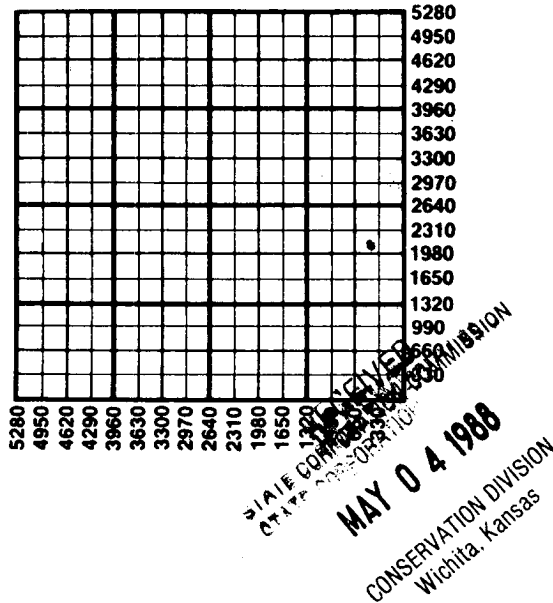

State Corporation Commission of Kansas
Conservation Division
200 Colorado Derby Building
Wichita, Kansas 67202
(316) 263-3238