

CARD MUST BE TYPED

State of Kansas

CARD MUST BE SIGNED

NOTICE OF INTENTION TO DRILL

(see rules on reverse side)

10

Starting Date 03 04 88
month day year

API Number 15— 199-20,145-00-00
Note: Skid rig 30' due to loss of hole East
Irregular Sec. 25 Twp. 15 S, Rg 43 X West
4950' Ft. from South Line of Section
360' Ft. from East Line of Section

OPERATOR: License # 5171
Name TXO Production Corp.
Address 1800 Lincoln Center Bldg.
City/State/Zip Denver, CO 80264
Contact Person Frank Tsuru
Phone 303-861-4246

(Note: Locate well on Section Plat on reverse side)

Nearest lease or unit boundary line .. 360 feet
County Wallace
Lease Name White AN Well # 1-X
Ground surface elevation .. 3917 feet MSL

CONTRACTOR: License # 6033
Name Murfin Drilling Company
City/State Wichita, KS

Domestic well within 330 feet: _____ yes X ___ no
Municipal well within one mile: _____ yes X ___ no
Depth to bottom of fresh water 300
Depth to bottom of usable water .. 1800
Surface pipe by Alternate: 1 ___ 2 X
Surface pipe planned to be set 500
Conductor pipe required None
Projected Total Depth 5300' feet
Formation Morrow

Well Drilled For: Well Class: Type Equipment:
X ___ Oil ___ SWD ___ Infield X ___ Mud Rotary
___ Gas ___ Inj X ___ Pool Ext. ___ Air Rotary
___ OWWO ___ Expl ___ Wildcat ___ Cable

If OWWO: old well info as follows:

Operator
Well Name
Comp Date Old Total Depth

I certify that well will comply with K.S.A. 55-101, et seq., plus eventually plugging hole to KCC specifications.

Date 3-4-88 Signature of Operator or Agent Title Asst' Drlg. Mgr.
Jack E. Goss, Agent For Operator

For KCC Use:


Conductor Pipe Required feet; Minimum Surface Pipe Required 320 feet per Alt. X 2
This Authorization Expires 9-7-88 Approved By Pat 3-7-88

Must be filed with the K.C.C. five (5) days prior to commencing well
This card void if drilling not started within six (6) months of date received by K.C.C.

Important procedures to follow:

1. Notify District office before setting surface casing.
2. Set surface casing by circulating cement to the top.
3. File completion forms ACO-1 with K.C.C. within 90 days of well completion, following instructions on ACO-1, side 1, and including copies of wireline logs.
4. Notify District office 48 hours prior to old well workover or re-entry.
5. Prior to filing Intent, prepare a proposed plugging plan in case well is D & A, then obtain approval of plan when calling district office prior to setting surface pipe.
6. Submit plugging report (CP-4) to K. C. C. after plugging is completed.
7. Obtain an approved injection docket number before disposing of salt water.
8. Notify K.C.C. within 10 days when injection commences or terminates.
9. If an alternate 2 completion, cement in the production pipe from below any usable water to surface within 120 days of spud date.

**A Regular Section of Land
1 Mile = 5,280 Ft.**

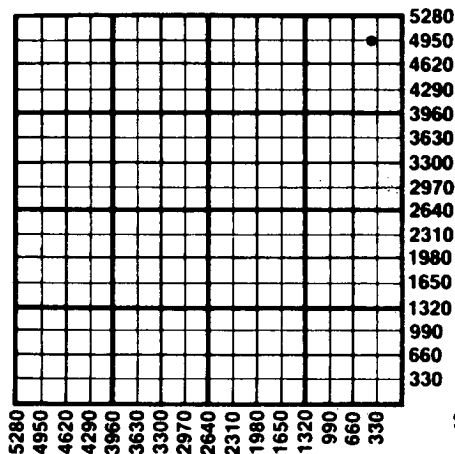

STATE CORPORATION COMMISSION

MAR 7 1988

CONSERVATION DIVISION
Wichita, Kansas

03-0788

State Corporation Commission of Kansas
Conservation Division
200 Colorado Derby Building
Wichita, Kansas 67202
(316) 263-3238