

CARD MUST BE TYPED

State of Kansas

CARD MUST BE SIGNED

NOTICE OF INTENTION TO DRILL

(see rules on reverse side)

199-20,135-0000 10

Expected Spud Date..... January 11, 1988
month day year

API Number 15— (Irregular section)

OPERATOR: License # 5171

NW Sec. 1 Twp. 15 S, Rg. 43 XX East West

Name TXO Production Corp.

Address 155 N. Market, Suite 1000

City/State/Zip Wichita, Kansas 67202

Contact Person..... Cory West

Phone..... (316) 269-7655

3500' Ft. from South Line of Section
± 900' Ft. from East Line of Section

(Note: Locate well on Section Plat on reverse side)

Nearest lease or unit boundary line 900' feet

County..... Wallace

CONTRACTOR: License # 6033

Lease Name..... HIBBERT "A" Well # 2

Name Murfin Drilling Co.

City/State..... Wichita, Kansas

Ground surface elevation TBD feet MSL

Well Drilled For: Well Class: Type Equipment:

Oil Storage Infield Mud Rotary

Gas Inj Pool Ext. Air Rotary

OWWO Expl Wildcat Cable

Domestic well within 330 feet: yes no

Municipal well within one mile: yes no

If OWWO: old well info as follows:

Depth to bottom of fresh water..... 350'

Depth to bottom of usable water 1800'

Surface pipe by Alternate: 1 2

Surface pipe planned to be set 650'

Conductor pipe required none

Projected Total Depth 5300' feet

Formation..... Morrow Sand

I certify that well will comply with K.S.A. 55-101, et seq., plus eventually plugging hole to KCC specifications.

Date 12-22-87 Signature of Operator or Agent Cory West Title..... Drlg. & Prod. Engineer

For KCC Use:

Conductor Pipe Required feet; Minimum Surface Pipe Required 400 feet per Alt. 2

This Authorization Expires 7-11-88 Approved By Pelt 1-11-88

EFFECTIVE DATE: ~~7-16-88~~


Must be filed with the K.C.C. five (5) days prior to commencing well
This card void if drilling not started within six (6) months of date received by K.C.C.

Important procedures to follow:

1. Notify District office before setting surface casing.
2. Set surface casing by circulating cement to the top.
3. File completion forms ACO-1 with K.C.C. within 120 days of well spud date, following instructions on ACO-1, side 1, and including copies of wireline logs.
4. Notify District office 48 hours prior to old well workover or re-entry.
5. Prior to filing Intent, prepare a proposed plugging plan in case well is D & A, then obtain approval of plan when calling district office prior to setting surface pipe.
6. Submit plugging report (CP-4) to K.C.C. after plugging is completed.
7. Obtain an approved injection docket number before disposing of salt water.
8. Notify K.C.C. within 10 days when injection commences or terminates.
9. If an alternate 2 completion, cement in the production pipe from below any usable water to surface within 120 days of spud date.

A Regular Section of Land 1 Mile = 5,280 Ft.

*1200 ft. Sec.
Approx. Loc.*

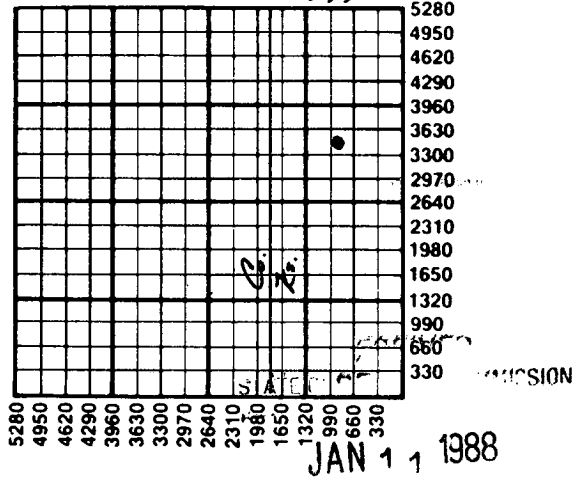

CONSERVATION DIVISION
Wichita, Kansas

State Corporation Commission of Kansas
Conservation Division
200 Colorado Derby Building
Wichita, Kansas 67202-1212
(316) 263-3238