

CARD MUST BE TYPED

State of Kansas

CARD MUST BE SIGNED

NOTICE OF INTENTION TO DRILL

(see rules on reverse side)

Expected Spud Date..... November 4, 1987
month day year

API Number 15-199-20,121-00-00 D+A

OPERATOR: License # 5238
Name Petroleum, Inc.
Address 301 N. Main, Suite 900
City/State/Zip Wichita, KS 67202
Contact Person Steve Phillips
Phone 316 624-1686

SW SW SW Sec. 20 Twp. 15 S, Rg. 42 East
330 West
4950
Ft. from South Line of Section
Ft. from East Line of Section

(Note: Locate well on Section Plat on reverse side)

CONTRACTOR: License # 6033
Name Murfin Drilling Co.
City/State 250 N. Water, #300, Wichita 67202

Nearest lease or unit boundary line 330 feet
County Wallace
Lease Name Bounds Well # 1

Well Drilled For: Well Class: Type Equipment:
 Oil Storage Infield Mud Rotary
 Gas Inj Pool Ext. Air Rotary
 OWWO Expl Wildcat Cable

Ground surface elevation feet MSL
Domestic well within 330 feet: yes no
Municipal well within one mile: yes no
Depth to bottom of fresh water 270'
Depth to bottom of usable water 1700'
Surface pipe by Alternate: 1 2
Surface pipe planned to be set 700'
Conductor pipe required
Projected Total Depth 5300' feet
Formation Morrow

If OWWO: old well info as follows:
Operator
Well Name
Comp Date Old Total Depth

I certify that well will comply with K.S.A. 55-101, et seq., plus eventually plugging hole to KCC specifications.
Date 11-2-87 Signature of Operator or Agent Title Pres. & Expl. Mgr.

For KCC Use:
Conductor Pipe Required feet; Minimum Surface Pipe Required 300 feet per Alt. 2
This Authorization Expires 5-2-88 Approved By 11-2-87


EFFECTIVE DATE: 11-7-87

Must be filed with the K.C.C. five (5) days prior to commencing well
 This card void if drilling not started within six (6) months of date received by K.C.C.

Important procedures to follow:

1. Notify District office before setting surface casing.
2. Set surface casing by circulating cement to the top.
3. File completion forms ACO-1 with K.C.C. within 120 days of well spud date, following instructions on ACO-1, side 1, and including copies of wireline logs.
4. Notify District office 48 hours prior to old well workover or re-entry.
5. Prior to filing Intent, prepare a proposed plugging plan in case well is D & A, then obtain approval of plan when calling district office prior to setting surface pipe.
6. Submit plugging report (CP-4) to K.C.C. after plugging is completed.
7. Obtain an approved injection docket number before disposing of salt water.
8. Notify K.C.C. within 10 days when injection commences or terminates.
9. Alternate 2 completion, cement in the production pipe from how any usable water to surface within 120 days of spud date.

A Regular Section of Land
1 Mile = 5,280 Ft.

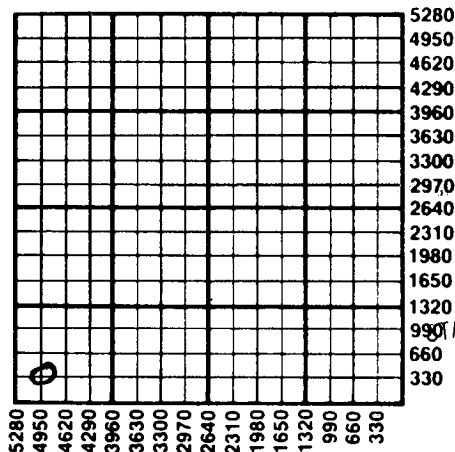

RECEIVED
 NOV 2 1987
 11-02-87
 STATE CORPORATION COMMISSION
 CONSERVATION DIVISION
 Wichita, Kansas

State Corporation Commission of Kansas
 Conservation Division
 200 Colorado Derby Building
 Wichita, Kansas 67202-1212
 (316) 263-3238