

CARD MUST BE TYPED

State of Kansas

CARD MUST BE SIGNED

NOTICE OF INTENTION TO DRILL CORRECTED

(see rules on reverse side)

✓ 10

Starting Date 04 18 88 month day year

API Number 15-199-20,151-00-00

OPERATOR: License # 8458
Name Transwestern Operating Company
Address P. O. Box 276
City/State/Zip Golden, CO 80202
Contact Person Doug Isern
Phone 303-279-2995

SW SW SE Sec. 19 Twp. 15 S, Rg. 42
\* 330 Ft. from South Line of Section
\* 2310 Ft. from East Line of Section

CONTRACTOR: License # 6033
Name Murfin Drilling Company
City/State Wichita, KS

(Note: Locate well on Section Plat on reverse side)
\* Nearest lease or unit boundary line 330 feet
County Wallace
Lease Name John Welsh Well # 1-19

Well Drilled For: Well Class: Type Equipment:
[X] Oil SWD Infield [X] Mud Rotary
Gas Inj Pool Ext Air Rotary
OWWO Expl [X] Wildcat Cable

Ground surface elevation feet MSL
Domestic well within 330 feet: yes [X] no
Municipal well within one mile: yes [X] no
Depth to bottom of fresh water 275
Depth to bottom of usable water 1850
Surface pipe by Alternate: 1 2
Surface pipe planned to be set 425
Conductor pipe required N/A
Projected Total Depth 5300 feet
Formation Morrow

If OWWO: old well info as follows:
Operator
Well Name
Comp Date Old Total Depth

I certify that well will comply with K.S.A. 55-101, et seq., plus eventually plugging hole to KCC specifications.
Date 4-18-88 Signature of Operator or Agent Jack L. Goss, Agent for Operator Title Ass't. Drlg. Mgr.

For KCC Use:
Conductor Pipe Required feet; Minimum Surface Pipe Required 3.50 feet per Alt.
This Authorization Expires 10-14-88 Approved By 4-18-88

EFFECTIVE DATE: 4-19-88

\* WAS: 460 FSL 2180 FEL N.L.L. 460'


ORIG. RCY'D 4-14-88

Must be filed with the K.C.C. five (5) days prior to commencing well  
This card void if drilling not started within six (6) months of date received by K.C.C.

**Important procedures to follow:**

1. Notify District office before setting surface casing.
2. Set surface casing by circulating cement to the top.
3. File completion forms ACO-1 with K.C.C. within 90 days of well completion, following instructions on ACO-1, side 1, and including copies of wireline logs.
4. Notify District office 48 hours prior to old well workover or re-entry.
5. Prior to filing Intent, prepare a proposed plugging plan in case well is D & A, then obtain approval of plan when calling district office prior to setting surface pipe.
6. Submit plugging report (CP-4) to K.C.C. after plugging is completed.
7. Obtain an approved injection docket number before disposing of salt water.
8. Notify K.C.C. within 10 days when injection commences or terminates.

**A Regular Section of Land**  
**1 Mile = 5,280 Ft.**

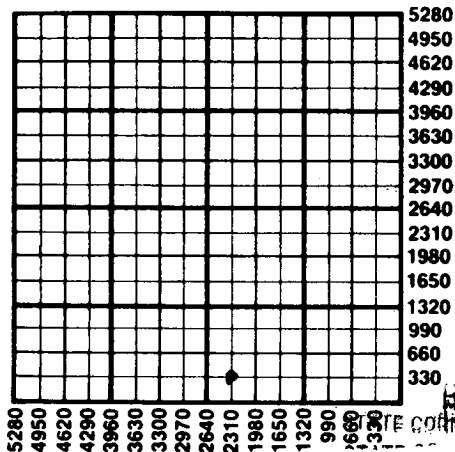

RECEIVED

APR 18 1988  
04-18-88  
CONSERVATION DIVISION  
Wichita, Kansas

in alternate 2 completion, cement in the production pipe from below any usable water to surface within 120 days of spud date.

State Corporation Commission of Kansas  
Conservation Division  
200 Colorado Derby Building  
Wichita, Kansas 67202  
(316) 263-3238