


WELL PLUGGING RECORD

Give All Information Completely
Make Required Affidavit
Mail or Deliver Report to:
Conservation Division
State Corporation Commission
800 Bitting Building
Wichita, Kansas

NORTH

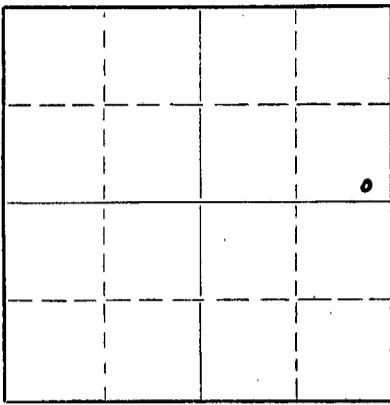

Locate well correctly on above
Section Plat

SALINE County, Sec. 26 Twp. 15 Rge. 4 (E) W (W)
Location as "NE/CNW%SW%" or footage from lines SE/4-SE/4-NE/4
Lease Owner M & H PETRO CORP
Lease Name GEO. NELSON Well No. 1
Office Address 645 NO. SANTA FE SALINA KANS.
Character of Well (completed as Oil, Gas or Dry Hole) DRY HOLE
Date well completed 3-23 19 53
Application for plugging filed 3-24 19
Application for plugging approved 3-24 19
Plugging commenced 3-24 19
Plugging completed 3-24 19
Reason for abandonment of well or producing formation DRY HOLE

If a producing well is abandoned, date of last production _____ 19____
Was permission obtained from the Conservation Division or its agents before plugging was commenced? YES

Name of Conservation Agent who supervised plugging of this well RUEL DURKEE
Producing formation _____ Depth to top _____ Bottom _____ Total Depth of Well 3416 Feet
Show depth and thickness of all water, oil and gas formations.

OIL, GAS OR WATER RECORDS

CASING RECORD

FORMATION	CONTENT	FROM	TO	SIZE	PUT IN	PULLED OUT
				<u>8 3/8</u>	<u>325</u>	<u>0</u>

Describe in detail the manner in which the well was plugged, indicating where the mud fluid was placed and the method or methods used in introducing it into the hole. If cement or other plugs were used, state the character of same and depth placed, from _____ feet to _____ feet for each plug set.

CIRCULATED HEAVY MUD ON BOTTOM & HALF WAY OUT OF HOLE - PUSHED WOODEN PLUG TO 195' & BRIDGED WITH ROCK TO 185' - RUN 15 SACKS CEMENT THROUGH DRILL PIPE - FILLED HOLE WITH MUD TO 30' & RUN 5 SACKS CEMENT FILLING HOLE TO CELLAR FLOOR

RECEIVED
STATE CORPORATION COMMISSION

MAR 27 1953
3-27-53
CONSERVATION DIVISION
Wichita, Kansas

(If additional description is necessary, use BACK of this sheet)
Name of Plugging Contractor SALINA DRILLING CORP
Address Box 566, SALINA KANS

STATE OF Kansas, COUNTY OF Saline ss.
Elmer Rider (employee of owner) or (owner or operator) of the above-described well, being first duly sworn on oath, says: That I have knowledge of the facts, statements, and matters herein contained and the log of the above-described well as filed and that the same are true and correct. So help me God.

(Signature) Elmer Rider
Box 566, Salina Kans. (Address)

SUBSCRIBED AND SWORN TO before me this 26 day of March, 1953

My commission expires April 19, 1954
Laurence J. Whitehouse Notary Public.

PLUGGING
FILE SEC 26 T 15 R 4 W
BOOK PAGE 87 LINE 11

ROTARY DRILLER'S LOG

15169.0038.0000

Nelson #1

Elevation by Laughlin & Simmons
1298 RB 1295 IF

SE SE NE Sec. 26,
Twp 15S, Range 14W,
Saline County

"CASING RECORD"
8 5/8" --328.35--250 sax Pozmix

Operator: M & H Petroleum Co.
645 North Santa Fe,
Salina, Kansas

Contractor: Salina Drilling Corp., Inc.,
Box #566,
Salina, Kansas.

Geologist: Donald H. Smith, 5206 E. Central

Well Commenced: 3-6-53
Well Completed: 3-24-53

Wichita,
Kansas.

FIGURES INDICATE BOTTOM OF FORMATIONS

Rotary Cable, Base & Celler	8	Lime & Shale	2725
Sand	175	Lime & Shale	2815
Shale & Shells	240	Lime & Shale	3005
Shale & Sand	275	Lime	3165
Anhydrite	310	Lime & Shale	2205
Shale & Shells	325	Lime & Shale	3295
Lime	500	Shale	3332
Lime	890	Hunton Lime	3350
Broken Lime	900	Shale	3405
Shale & Shells	1855	Lime & Shale	3416
Broken Lime	2120		
Lime	2199S		
Shale & Shells	2240		
Broken Lime	2345		
Lime	2465		
Broken Lime	2560		
Lime	2635		
Shale	2650		

TOPS, etc. as Picked by GEOLOGIST

Mississippi	2886
Kinderhook Shale	3181
Shaly Misener Sand	3316
Hunton	3317
Maquoketa Shale	3335
Maquoketa Dolomite	3413

RECEIVED
STATE CORPORATION COMMISSION
MAY 15 1953
CONSERVATION DIVISION
Wichita, Kansas

The above Rotary Driller's Log is complete and correct to the best of my knowledge.

SALINA DRILLING CORPORATION, INC.

Loren S. Hallam
President.

PLUGGING
FILE SEC 26 T 15 R 4 W
BOOK PAGE 87 LINE 11