


STATE OF KANSAS
STATE CORPORATION COMMISSION

WELL PLUGGING RECORD

Give All Information Completely
Make Required Affidavit
Mail or Deliver Report to:
Conservation Division
State Corporation Commission
211 No. Broadway
Wichita, Kansas

Saline County, Sec. 35 Twp. 15 Rge. 1 (E) (W) X

NORTH

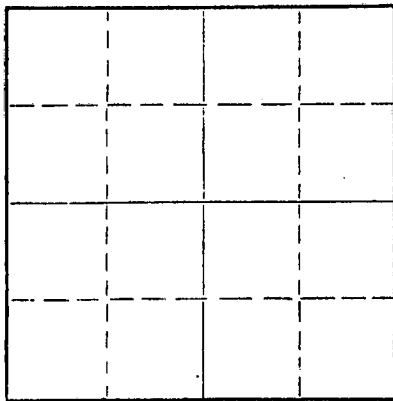

Locate well correctly on above
Section Plat

Location as "NE/CNWxSWx" or footage from lines. NE 1/4
Lease Owner Mobil Oil Company
Lease Name Ohorg Well No. 3
Office Address P. O. Box 196 Clafin, Kansas
Character of Well (completed as Oil, Gas or Dry Hole) _____
Date well completed _____ 19____
Application for plugging filed _____ 19____
Application for plugging approved _____ 19____
Plugging commenced 1-21-65 _____ 19____
Plugging completed 2-1-65 _____ 19____
Reason for abandonment of well or producing formation _____
Dry
If a producing well is abandoned, date of last production _____ 19____
Was permission obtained from the Conservation Division or its agents before plugging was commenced? Yes

Name of Conservation Agent who supervised plugging of this well Gilbert J. Toman
Producing formation _____ Depth to top _____ Bottom _____ Total Depth of Well 3120 Feet
Show depth and thickness of all water, oil and gas formations.

OIL, GAS OR WATER RECORDS

CASING RECORD

FORMATION	CONTENT	FROM	TO	SIZE	PUT IN	PULLED OUT
				8 5/8	260	None
				1 1/2	None	1897

Describe in detail the manner in which the well was plugged, indicating where the mud fluid was placed and the method or methods used in introducing it into the hole. If cement or other plugs were used, state the character of same and depth placed, from _____ feet to _____ feet for each plug set.

Cleaned out cellar. Sanded to 3100'.
Dumped 3 sacks of cement. Working pipe. Shot pipe at 2900'. Mud came in at 2300'.
Working pipe. Measured to 1900'. Shot pipe at 1900'. Pulling pipe.
Pulling pipe.
Plugging well with mud rock bridge at 225'. Dumped 20 sacks of cement.
Filled hole. Capped well with 10 sacks of cement.

RECEIVED
STATE CORPORATION COMMISSION
FEB 12 1965
2-12-65
CONSERVATION DIVISION
Wichita, Kansas

(If additional description is necessary, use BACK of this sheet)

Name of Plugging Contractor Forbes Casing Pulling, Inc.
Address P. O. Box 221 Great Bend, Kansas

STATE OF Kansas, COUNTY OF Barton, ss.
J. O. Forbes (employee of owner) or (owner or operator) of the above-described well, being first duly sworn on oath, says: That I have knowledge of the facts, statements, and matters herein contained and the log of the above-described well as filed and that the same are true and correct. So help me God.

(Signature) J. O. Forbes
P. O. Box 221 Great Bend, Kansas
(Address)

SUBSCRIBED AND SWORN TO before me this 10 day of February, 19 65
My commission expires May 27, 1965
Gilbert J. Toman Notary Public.

Give All Information Completely
Make Required Affidavit
Mail or Deliver Report to:
Conservation Division
State Corporation Commission
211 No. Broadway
Wichita, Kansas

dup
WELL PLUGGING RECORD

Saline County. Sec. 35 Twp. 15 Rge. 4W (X) (W)

Location as "NE/CNW&SW&" or footage from lines NE NW NE

Lease Owner Socony Mobil Oil Company, Inc.

Lease Name Oborg Well No. 3

Office Address 300 N. Broadway, Wichita, Kansas 67202

Character of Well (completed as Oil, Gas or Dry Hole) Oil

Date well completed December 8 19 51

Application for plugging filed December 10 19 65

Application for plugging approved December 11 19 65


Plugging commenced January 24 19 65

Plugging completed February 4 19 65

Reason for abandonment of well or producing formation Depleted

If a producing well is abandoned, date of last production _____ 19 _____

Was permission obtained from the Conservation Division or its agents before plugging was commenced? Yes

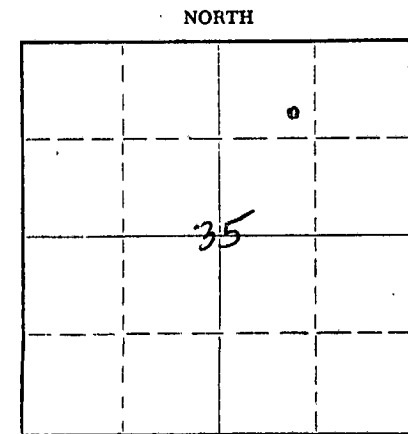

Locate well correctly on above Section Plat

Name of Conservation Agent who supervised plugging of this well Gilbert J. Toman

Producing formation Viola Depth to top _____ Bottom _____ Total Depth of Well 3421' Feet

Show depth and thickness of all water, oil and gas formations.

OIL, GAS OR WATER RECORDS

CASING RECORD

FORMATION	CONTENT	FROM	TO	SIZE	PUT IN	PULLED OUT
<u>Viola</u>	<u>Oil</u>	<u>-</u>	<u>-</u>	<u>8 5/8</u>	<u>310'</u>	<u>None</u>
				<u>4 1/2</u>	<u>3420</u>	<u>1897</u>

Describe in detail the manner in which the well was plugged, indicating where the mud fluid was placed and the method or methods used in introducing it into the hole. If cement or other plugs were used, state the character of same and depth placed, from _____ feet to _____ feet for each plug set.

Cleaned out cellar. Sanded to 3400'.

Dumped 3 sacks of cement. Working pipe. Shot pipe at 2900'.
Mud came in at 2300'.

Working pipe. Measured to 1900'. Shot pipe at 1900'. Pulling pipe.

Pulling pipe.

Plugging well with mud rock bridge at 225'. Dumped 20 sacks of cement.
Filled hole. Capped well with 10 sacks of cement.

RECEIVED
STATE CORPORATION COMMISSION

FEB 23 1965

CONSERVATION DIVISION
Wichita, Kansas

(If additional description is necessary, use BACK of this sheet)

Name of Plugging Contractor Forbes Casing Pulling, Inc.

Address P. O. Box 221, Great Bend, Kansas

STATE OF Kansas, COUNTY OF Sedgwick, ss.

T. V. Herriage (employee of owner) or ~~(owner or operator)~~ of the above-described well, being first duly sworn on oath, says: That I have knowledge of the facts, statements, and matters herein contained and the log of the above-described well as filed and that the same are true and correct. So help me God.

(Signature) T. V. Herriage Acctg. Group Supr.

300 N. Broadway, Wichita, Kansas 67202
(Address)

SUBSCRIBED AND SWORN TO before me this 19th day of February, 1965

My commission expires 4-4-66

Notary Public.



Notary

ROTARY DRILLER'S LOG

15:69-00857-0000

E. K. Carey Contractor - Operator
 Box 620
 McPherson, Kansas

K. B. 1309
 Elevation: D. F. 1306
 Gr. 1304

Oborg #3

8-5/8" x 4 1/2" Head 6.60'
 below K. B.

NE NW NE
 Sec. 35-15S-4W
 Saline County, Kansas

Casing Record:

8-5/8" 310' w/250 sacks

4 1/2" 3420' w/75 sacks,
 set 1' off bottom

Well Commenced: 11-4-51
 Well Completed: 11-17-51

Contractor: E. K. Carey, Contractor (Rig #2) Box 620, McPherson, Kansas
 Geologist: Don Hollar, E. K. Carey Drilg. Co. 315 Central Bldg. Wichita

Figures Indicate Bottom of Formation K. B.

Cellar	8	Lime	2275
Clay	15	Lime	2395
Sand	20	Lime	2495
Shale	38	Lime	2540
Sand	50	Lime	2610
Shale	70	Shale & lime	2630
Shale & shells	130	Shale & lime	2720
Lime & shale	185	Shale & lime	2797
Lime & shale	258	Shale & lime	2870
Sand & shale	261	Shale	2911
Lime & shale	310	Lime	2955
Lime & shale	440	Lime	3000
Lime & shale	655	Lime	3060
Lime & shale	723	Lime	3115
Salt	728	Lime	3142
Lime & shale	860	Lime	3170
Lime & shale	1000	Lime	3192
Shale & shells	1105	Shale	3235
Shale & shells	1500	Shale	3305
Shale & lime	1660	Shale	3340
Shale	1715	Lime	3346
Shale	1850	Shale	3362
Shale & lime	1975	Shale	3403
Lime & shale	2075	Shale	3420
Lime & shale	2100	Lime	3421
Shale & shells	2205		
Shale & lime	2255		

RECEIVED
 STATE CORPORATION COMMISSION

DEC 14 1964

CONSERVATION DIVISION
 Wichita, Kansas

Geologist Tops:

Mississippi	2912 (-1603)	Maquoketa Dol.	3420 (-2111)
Kinderhook	3192	Rotary T. D.	3421
Hunton	3338	Set 4 1/2" casing @	3420
Maquoketa Shale	3348		

The above Rotary Driller's Log is complete and correct to the best of my knowledge.

E. K. CAREY, CONTRACTOR

Herbert J. Thomas