

WELL PLUGGING RECORD

Give All Information Completely
Make Required Affidavit
Mail or Deliver Report to:
Conservation Division
State Corporation Commission
211 No. Broadway
Wichita, Kansas

Saline County, Sec. 35 Twp. 15S Rge. 4 (E) (W) X

Location as "NE/CNWKSWK" or footage from lines SE SE NE

Lease Owner Mobil Oil Company

Lease Name Oborg Well No. 2

Office Address P. O. Box 196 Claflin, Kansas

Character of Well (completed as Oil, Gas or Dry Hole)

Date well completed 19

Application for plugging filed 19

Application for plugging approved 19

Plugging commenced 2-17-65 19


Plugging completed 2-25-65 19

Reason for abandonment of well or producing formation

Dry

If a producing well is abandoned, date of last production 19

Was permission obtained from the Conservation Division or its agents before plugging was commenced? Yes

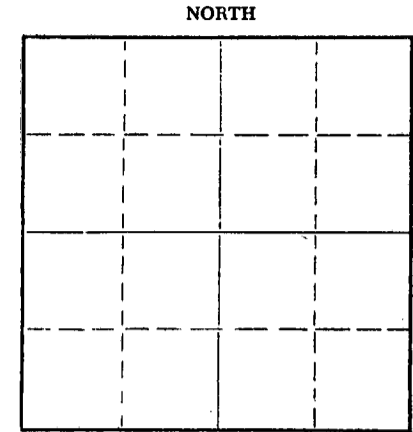

Locate well correctly on above Section Plat

Name of Conservation Agent who supervised plugging of this well Gilbert J. Toman

Producing formation Depth to top Bottom Total Depth of Well 3421 Feet

Show depth and thickness of all water, oil and gas formations.

OIL, GAS OR WATER RECORDS

CASING RECORD

FORMATION	CONTENT	FROM	TO	SIZE	PUT IN	PULLED OUT
				8 5/8	312	None
				5 1/2	None	2111

Describe in detail the manner in which the well was plugged, indicating where the mud fluid was placed and the method or methods used in introducing it into the hole. If cement or other plugs were used, state the character of same and depth placed, from feet to feet for each plug set.

Broke out cement. Cleaned out cellar. Sanded to 3400'. Dumped 5 sacks of cement. Working pipe.

Working pipe. Shot pipe at 2800' - 2700' - 2600' & 2500'. Circulating. Spotted 60 bbl. of oil.

Working pipe.

Working pipe. Shot pipe at 2400' - 2300' - 2200' & 2100'. Pulling pipe.

Pulling pipe. Plugging well. Build rock bridge at 250'. Dumped 20 sacks of cement. Filled hole and rock bridge. Capped well with 10 sacks of cement.

RECEIVED
STATE CORPORATION COMMISSION

MAR 4 1965

3-4-65

CONSERVATION DIVISION
Wichita, Kansas

(If additional description is necessary, use BACK of this sheet)

Name of Plugging Contractor Forbes Casing Pulling, Inc.

Address P. O. Box 221 Great Bend, Kansas

STATE OF Kansas, COUNTY OF Barton, ss.

J. O. Forbes

(employee of owner) or (owner or operator) of the above-described

well, being first duly sworn on oath, says: That I have knowledge of the facts, statements, and matters herein contained and the log of the above-described well as filed and that the same are true and correct. So help me God.

(Signature) J. O. Forbes

P. O. Box 221 Great Bend, Kansas

(Address)

SUBSCRIBED AND SWORN TO before me this 2 day of March, 1965

My commission expires May 27, 1965

Notary Public.

STATE OF KANSAS
STATE CORPORATION COMMISSION


Give All Information Completely
Make Required Affidavit
Mail or Deliver Report to:
Conservation Division
State Corporation Commission
211 No. Broadway
Wichita, Kansas

date
WELL PLUGGING RECORD

Saline County, Sec. 35 Twp. 15S Rge. 4W (E) (W)

Location as "NE/CNW%SW%" or footage from lines SE SE ne
Lease Owner Socony Mobil Oil Company, Inc.
Lease Name Oborg Well No. 2
Office Address 300 N. Broadway, Wichita, Kansas 67202
Character of Well (completed as Oil, Gas or Dry Hole) Oil
Date well completed March 19 54
Application for plugging filed 12-10-64 19
Application for plugging approved 12-11-64 19
Plugging commenced 2-17-65 19
Plugging completed 2-25-65 19
Reason for abandonment of well or producing formation Depleted

NORTH

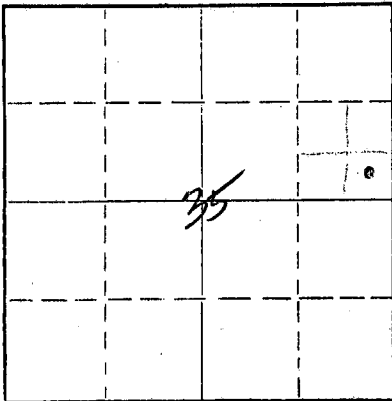

Locate well correctly on above Section Plat

If a producing well is abandoned, date of last production December 19 64
Was permission obtained from the Conservation Division or its agents before plugging was commenced? Yes

Name of Conservation Agent who supervised plugging of this well Gilbert J. Toman
Producing formation _____ Depth to top _____ Bottom _____ Total Depth of Well 3421 Feet
Show depth and thickness of all water, oil and gas formations.

OIL, GAS OR WATER RECORDS

CASING RECORD

FORMATION	CONTENT	FROM	TO	SIZE	PUT IN	PULLED OUT
				8 5/8	312	None
				5 1/2	3420'	2111

Describe in detail the manner in which the well was plugged, indicating where the mud fluid was placed and the method or methods used in introducing it into the hole. If cement or other plugs were used, state the character of same and depth placed, from _____ feet to _____ feet for each plug set.

Broke out cement. Cleaned out cellar, sanded to 3400'. Dumped 5 sacks of cement. Working pipe.
Working pipe. Shot pipe at 2800-2700' - 2600 & 2500'. Circulating. Spotted 60 bbl. of oil.
Working pipe.
Working pipe. Shot pipe at 2400-2300' - 2200' & 2100'. Pulling pipe.
Pulling pipe. Plugging well. Build rock bridge at 250'. Dumped 20 sacks of cement. Filled hole and rock bridge. Capped well with 10 sacks of cement.

RECEIVED
STATE CORPORATION COMMISSION

MAR 10 1965


(If additional description is necessary, use BACK of this sheet)
Name of Plugging Contractor Forbes Casing Pulling, Inc. CONSERVATION DIVISION
Address P. O. Box 221, Great Bend, Kansas Wichita, Kansas

STATE OF Kansas COUNTY OF Sedgwick, ss.
T. V. Herriage (employee of owner) or (owner or operator) of the above-described well, being first duly sworn on oath, says: That I have knowledge of the facts, statements, and matters herein contained and the log of the above-described well as filed and that the same are true and correct. So help me God.

(Signature) T. V. Herriage Dist. Acctg. Group Supr.
300 N. Broadway, Wichita, Kansas 67202
(Address)

SUBSCRIBED AND SWORN TO before me this 9th day of March 19 65

My commission expires 4-4-66

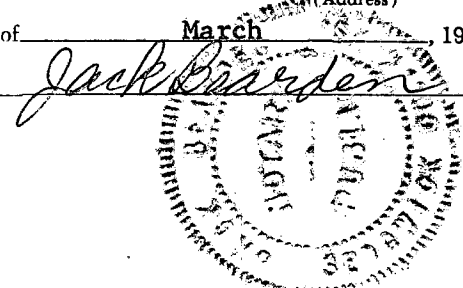

Notary Public.

ROTARY DRILLER'S LOG

15169-00856-0000 37
5/6

E. K. Carey, Contractor - Operator
Box 620
McPherson, Kansas

Elevation: 1307 DF
1310 KB

Oborg #2

Top 8 5/8" x 5 1/2" Head 6.80'
below K.B..

C SE 1/4 SE 1/4 NE 1/4
Sec. 35-15S-4W
Saline County, Kansas

Casing Record:

Well Commenced: 9-6-51
Well Completed: 9-21-51

8 5/8" - 312' cemented with
250 sacks.
5 1/2" - 3420' cemented with
75 sacks.

Contractor: E. K. Carey, Contractor (Rig #2) Box 620 - McPherson, Kansas
Geologist: Don D. Hollar - 815 Central Building - Wichita, Kansas

Figures Indicate Bottom of Formation K. B.

Base & Cellar	8	Lime & Shale	2700
Clay & Shale	38	Shale & Lime	2760
Sand	41	Shale & Shells	2880
Shale	85	Shale & Shells	2908
Shale & Shells	250	Lime	3192
Shale & Shells	327	Shale	3270
Lime & Shale	1035	Shale & Lime	3334
Shale & Shells	1445	Shale	3419
Shale & Lime	1825	Lime	3421
Lime & Shale	2155		
Shale & Lime	2230		
Shale	2257		
Lime	2630		

RECEIVED
STATE CORPORATION COMMISSION

DEC 14 1964

CONSERVATION DIVISION
Wichita, Kansas

GEOLOGIST TOPS:

Mississippi Lime	2900 (-1590)	Maquoketa Shale	3348 (-2038)
Kinderhook	3192 (-1882)	Maquoketa Dolomite	3419 (-2109)
Hunt	3340 (-2030)	Total Depth	3421 (-2111)

The above Rotary Driller's Log is complete and correct to the best of my knowledge.

E. K. Carey, Contractor

By Herbert Rhoton, Superintendent.