


CALVIN EXPLORATION, INC. DEC 18 '81

STATE OF KANSAS  
STATE CORPORATION COMMISSION

WELL PLUGGING RECORD

Give All Information Completely  
Make Required Affidavit  
Mail or Deliver Report to  
Conservation Division  
State Corporation Comm.  
245 North Water  
Wichita, KS 67202

Meade County. Sec. 25 Twp. 33 Rge. 30 R/W  
Location as "NE/CNW $\frac{1}{2}$ SW $\frac{1}{2}$ " or footage from lines  
940' FWL & 2565' FNL  
Lease Owner Calvin Exploration Inc.  
Lease Name Novinger Well No. 1-25  
Office Address Box 6, Liberal, Ks. 67901  
Character of Well (Completed as Oil, Gas or Dry Hole)  
Gas Well  
Date Well completed 9-16-80 19  
Application for plugging filed 6-18-81 19  
Application for plugging approved 6-30-81 19  
Plugging commenced 12-7-81 19  
Plugging completed 12-10-81 19  
Reason for abandonment of well or producing formation  
Non Commercial Value  
If a producing well is abandoned, date of last production  
None 19  
Was permission obtained from the Conservation Division or  
its agents before plugging was commenced? yes  
Name of Conservation Agent who supervised plugging of this well Mr. Luthi  
Producing formation Narrow Depth to top 5796 Bottom 5804 Total Depth of Well 5915  
Show depth and thickness of all water, oil and gas formations.

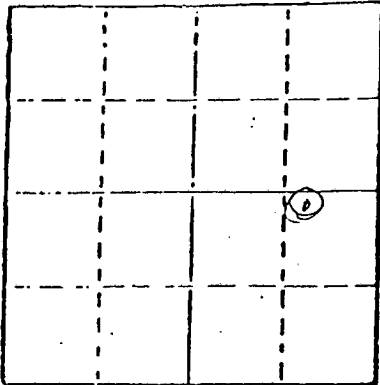

Locate well correctly on above  
Section Plat

OIL, GAS OR WATER RECORDS

CASING RECORD

FORMATION	CONTENT	FROM	TO	SIZE	PUT IN	PULLED OUT
Surface				8 5/8"	1518	0
Production				4 1/2"	5915	3220

Describe in detail the manner in which the well was plugged, indicating where the mud fluid was placed and the method or methods used in introducing it into the hold. If cement or other plugs were used, state the character of same and depth placed, from \_\_\_\_\_ feet to \_\_\_\_\_ feet for each plug set.

Pumped 1 sk. hulls & 15 sks. cement to 5650' Pressured to 750 lbs.  
Displaced w/mud to 1500'  
Pumped 35 sks. cement 1500' to 1400'  
Displaced w/mud to 40'  
Put bridge & 10 sks. cement 50' to 0'  
Cut off 8 5/8", 42' below ground level

(If additional description is necessary, use BACK of this sheet)

Name of Plugging Contractor Midwest Casing Pulling Service  
Permit #766

STATE OF KANSAS COUNTY OF HASKELL, ss.  
I, Edgar J. Eves (employee of owner) or (owner or operator)

of the above-described well, being first duly sworn on oath, says: That I have knowledge of the facts, statements, and matters herein contained and the log of the above-described well as filed and that the same are true and correct. So help me, God.

(Signature)

Box F, Sublette, Ks.  
(Address)

SUBSCRIBED AND SWORN TO before me this 14th day of Dec., 1981


*Edgar J. Eves*

Notary Public.

RECEIVED

STATE CORPORATION COMMISSION

My commission expires 12-16-84

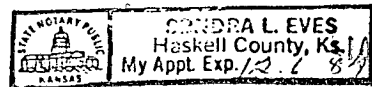

DEC 27 1982

CONSERVATION DIVISION  
Wichita, Kansas

15-119. 20409 -00-00

Drillers Log

Novinger #1-25

CALVIN EXPLORATION, INC. JUN 02 '80

CASING RECORD:  
8 5/8" set at 1615'  
w/ 750 sacks cement

OPERATOR: Calvin Exploration, Inc.

DESCRIPTION:

CONTRACTOR: Search Drilling Co.

W/2, Sec. 25-33S-30W  
Meade County, Kansas

TOTAL DEPTH:

COMMENCED: June 12, 1980

5915'

COMPLETED: June 26, 1980

FORMATION

FROM

TO

REMARKS

Clay and Sand  
Sand  
Red Bed  
Red Bed and Shale  
Lime and Shale  
Rotary Total Depth

0  
496  
525  
1525  
2280  
5915

496  
525  
1525  
2280  
5915

Ran 144 joints of  
4 1/2" set at 5920'  
w/ 175 sacks 50-50  
posmix, 18% salt,  
10% Gilsonite, 1/2%  
CFR-2. Plug down at  
7:30 P.M. on June 26,  
1980.

I certify that this is a true and correct copy of the above log to the best of my knowledge.

SEARCH DRILLING CO.

*N. J. Johnson*  
N. J. Johnson

RECEIVED  
STATE CORPORATION COMMISSION

JUN 23 1981

Subscribed and sworn to before me this 30th day of June, 1980.

My Commission Expires:  
February 22, 1981

CONSERVATION DIVISION  
Wichita, Kansas

*Maxine Dressen*  
Maxine Dressen  
Notary Public

