

CARD MUST BE TYPED

State of Kansas
NOTICE OF INTENTION TO DRILL
(see rules on reverse side)

CARD MUST BE SIGNED

Starting Date: November 5 1984
month day year

API Number 15- 071-20,349-00-00
CORRECTION

OPERATOR: License # 5238
Name Petroleum, Inc.
Address 300 W. Douglas, Suite 800
City/State/Zip Wichita, Ks. 67202
Contact Person Steve Phillips
Phone 316-624-1686

SW NE NW Sec 7 Twp 16 S, Rge 42
(location) East West

4290 Ft North from Southeast Corner of Section
3696 Ft West from Southeast Corner of Section
(Note: Locate well on Section Plat on reverse side)

CONTRACTOR: License # 5382
Name Cheyenne Drilling, Inc.
City/State P. O. Box 916, Garden City, Ks 67846

Nearest lease or unit boundary line 990 feet.
County Greeley
Lease Name Garvey, Inc. 'P' Well# 3

Well Drilled For: Well Class: Type Equipment:
 Oil Swd Infield Mud Rotary
 Gas Inj Pool Ext. Air Rotary
 OWWO Expl Wildcat Cable

Domestic well within 330 feet: yes no
Municipal well within one mile: yes no

If OWWO: old well info as follows:

Operator
Well Name
Comp Date Old Total Depth
Projected Total Depth 5250 feet
Projected Formation at TD
Expected Producing Formations

270
Depth to Bottom of fresh water feet
Lowest usable water formation Dakota
Depth to Bottom of usable water 1700 feet
Surface pipe by Alternate: 1 2
Surface pipe to be set 1700 feet
Conductor pipe if any required --- feet
Ground surface elevation --- feet MSL
This Authorization Expires 5-3-85
Approved By 11-6-84 RCH

I certify that we will comply with K.S.A. 55-101, et seq., plus eventually plugging holes to K.C.C. specifications.

Date 11-6-84 Signature of Operator or Agent *Steve Phillips* Title

Location Corrected
Records Manager

* WAS: 4950 FSL, SW-NE-NW Form C-1 4/84


Must be filed with the K.C.C. five (5) days prior to commencing well
This card void if drilling not started within six (6) months of date received by K.C.C.

NOV 06 1984

CONSERVATION DIVISION
Wichita, Kansas

11-06-84

A Regular Section of Land
1 Mile = 5,280 Ft.

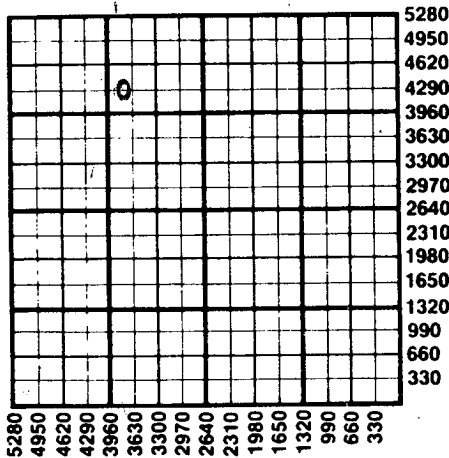

Important procedures to follow :

1. Notify District office before setting surface casing.
2. Set surface casing by circulating cement to the top.
3. File completion forms ACO-1 with K.C.C. within 90 days of well completion, following instructions on ACO-1, side 1, and including copies of wireline logs.
4. Notify District office 48 hours prior to old well workover or re-entry.
5. Prior to plugging, prepare a plugging plan, then obtain agreement from the appropriate district office for an approved plugging plan.
6. Submit plugging report (CP-4) to K.C.C. after plugging is completed.
7. Obtain an approved injection docket number before disposing of salt water.
8. Notify K.C.C. within 10 days when injection commences or terminates.
9. If an alternate 2 completion, cement in the production pipe from below any usable water to surface within 120 days of spud date.

State Corporation Commission of Kansas
Conservation Division
200 Colorado Derby Building
Wichita, Kansas 67202
(316) 263-3238