

CARD MUST BE TYPED

State of Kansas  
**NOTICE OF INTENTION TO DRILL**  
(see rules on reverse side)

CARD MUST BE SIGNED

Starting Date: April 20 1985  
month day year

API Number 15- 071-20,362-00-00

OPERATOR: License # 5238  
Name Petroleum, Inc.  
Address 300 W. Douglas, Suite 800  
City/State/Zip Wichita, Ks. 67202  
Contact Person Steve Phillips  
Phone 316 624-1686

NW NE NW Sec 7 Twp 16 S, Rge 42W  
(location)  East  West

4950 Ft North from Southeast Corner of Section  
3696 Ft West from Southeast Corner of Section  
(Note: Locate well on Section Plat on reverse side)

CONTRACTOR: License # 5382  
Name Cheyenne Drilling, Inc.  
City/State P. O. Box 916, Garden City, Ks 67846

Nearest lease or unit boundary line 330 feet.  
County Greeley  
Lease Name Garvey, Inc. 'P' Well# 4

Well Drilled For: Well Class: Type Equipment:  
 Oil  Swd  Infield  Mud Rotary  
 Gas  Inj  Pool Ext.  Air Rotary  
 OWWO  Expl  Wildcat  Cable

Domestic well within 330 feet:  yes  no  
Municipal well within one mile:  yes  no

If OWWO: old well info as follows:

Operator  
Well Name  
Comp Date Old Total Depth  
Projected Total Depth 5250' feet  
Projected Formation at TD  
Expected Producing Formations


Depth to Bottom of fresh water 270 feet  
Lowest usable water formation Dakota  
Depth to Bottom of usable water 1700 feet  
Surface pipe by Alternate: 1  2   
Surface pipe to be set 1700 feet  
Conductor pipe if any required -- feet  
Ground surface elevation -- feet MSL  
This Authorization Expires 10-15-85  
Approved By 4-15-85 PC

I certify that we will comply with K.S.A. 55-101, et seq., plus eventually plugging hole to K.C.C. specifications.

Date 4-15-85 Signature of Operator or Agent [Signature] Title Records Manager  
mhc/uohe 4-15-85 Form C-1 4/84

Must be filed with the K.C.C. five (5) days prior to commencing well  
This card void if drilling not started within six (6) months of date received by K.C.C.

A Regular Section of Land  
1 Mile = 5,280 Ft.

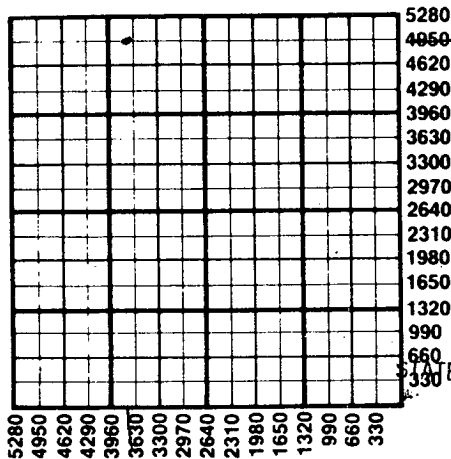

**Important procedures to follow :**

1. Notify District office before setting surface casing.
  2. Set surface casing by circulating cement to the top.
  3. File completion forms ACO-1 with K.C.C. within 90 days of well completion, following instructions on ACO-1, side 1, and including copies of wireline logs.
  4. Notify District office 48 hours prior to old well workover or re-entry.
  5. Prior to plugging, prepare a plugging plan, then obtain agreement from the appropriate district office for an approved plugging plan.
  6. Submit plugging report (CP-4) to K.C.C. after plugging is completed.
  7. Obtain an approved injection docket number before disposing of salt water.
  8. Notify K.C.C. within 10 days when injection commences or terminates.
- If an alternate 2 completion, cement in the production pipe from below any usable water to surface within 120 days of spud date.

RECEIVED  
STATE CORPORATION COMMISSION

APR 15 1985  
04-15-85  
GUIDANCE DIVISION  
Wichita, Kansas

State Corporation Commission of Kansas  
Conservation Division  
200 Colorado Derby Building  
Wichita, Kansas 67202  
(316) 263-3238