

CARD MUST BE TYPED CORRECTED NOTICE OF INTENTION TO DRILL  
(see rules on reverse side)

CORRECTED  
10-16-84  
CARD MUST BE SIGNED

Starting Date: 10 19 84  
month day year

API Number 15- 071-20,341-00-00  East

OPERATOR: License # 7506  
Name First Energy Corporation  
Address 16701 Greenspoint Park Dr., Ste. 200  
City/State/Zip Houston, TX 77060  
Contact Person Bill Dean  
Phone 713-847-5755

K.C. SW SW Sec 5 Twp 16 S, Rge 42 West  
(location)

\* 660 Ft North from Southeast Corner of Section  
\* 4620 Ft West from Southeast Corner of Section  
(Note: Locate well on Section Plat on reverse side)

CONTRACTOR: License # 6033  
Name Murfin Drilling Company  
City/State Wichita, KS 67202

Nearest lease or unit boundary line 660 feet.  
County Greeley

Lease Name Sloan \* Well# 14-5 (40)

Domestic well within 330 feet:  yes  no  
Municipal well within one mile:  yes  no

Well Drilled For: Well Class: Type Equipment:  
 Oil  Swd  Infield  Mud Rotary  
 Gas  Inj  Pool Ext.  Air Rotary  
 OWWO  Expl  Wildcat  Cable

Depth to Bottom of fresh water 150 feet  
Lowest usable water formation Dakota  
Depth to Bottom of usable water 1700 feet

Surface pipe by Alternate: 1  2   
Surface pipe to be set 450 feet  
Conductor pipe if any required N/A feet  
Ground surface elevation feet MSL

If OWWO: old well info as follows:

Operator

Well Name

Comp Date Old Total Depth

Projected Total Depth 5300 feet

Projected Formation at TD Miss

Expected Producing Formations LKC

This Authorization Expires 4-12-85

Approved By 10-12-84

I certify that we will comply with K.S.A. 55-101, et seq., plus eventually plugging hole to K.C.C. specifications.

\* was CDE SWSE # 27-5  
PROFSL #290FEL

Date 10-16-84

Signature of Operator or Agent

David L. Murfin, Agent for Operator

Title


Drilling Manager

RECEIVED  
STATE CORPORATION COMMISSION

This card void if drilling not started within six (6) months of date received by K.C.C.

OCT 16 1984

CONSERVATION DIVISION  
Wichita, Kansas  
A Regular Section of Land  
1 Mile = 5,280 Ft.

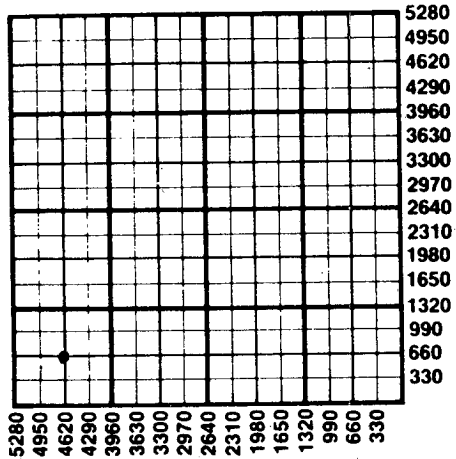

TK

Important procedures to follow :

1. Notify District office before setting surface casing.
2. Set surface casing by circulating cement to the top.
3. File completion forms ACO-1 with K.C.C. within 90 days of well completion, following instructions on ACO-1, side 1, and including copies of wireline logs.
4. Notify District office 48 hours prior to old well workover or re-entry.
5. Prior to plugging, prepare a plugging plan, then obtain agreement from the appropriate district office for an approved plugging plan.
6. Submit plugging report (CP-4) to K.C.C. after plugging is completed.
7. Obtain an approved injection docket number before disposing of salt water.
8. Notify K.C.C. within 10 days when injection commences or terminates.
9. If an alternate 2 completion, cement in the production pipe from below any usable water to surface within 120 days of spud date.

State Corporation Commission of Kansas  
Conservation Division  
200 Colorado Derby Building  
Wichita, Kansas 67202  
(316) 263-3238