

CARD MUST BE TYPED

State of Kansas

CARD MUST BE SIGNED

NOTICE OF INTENTION TO DRILL

(see rules on reverse side)

Starting Date 2 14 87
month day year

API Number 15— 071-20,431-00-00

OPERATOR: License # 9421
Name BOGER BROTHERS DRILLING, INC.
Address P.O. Box 723
City/State/Zip Great Bend, KS 67530
Contact Person Steve Mitchell
Phone 316/792-8151

~~East~~
C-~~W~~/2 NW NW Sec. 22 Twp. 16 S, Rg. 42... West
4620 Ft. from South Line of Section
4950 Ft. from East Line of Section

(Note: Locate well on Section Plat on reverse side)

CONTRACTOR: License #
Name Unknown
City/State

Nearest lease or unit boundary line 330 feet
County GREELEY

Lease Name YOUNG CATTLE CO. Well # 1

Ground surface elevation ~~est.~~ 3830 feet MSL

Domestic well within 330 feet: _____ yes no

Well Drilled For: Well Class: Type Equipment:
 Oil _____ SWD _____ Infield Mud Rotary
_____ Gas _____ Inj _____ Pool Ext. _____ Air Rotary
_____ OWWO _____ Expl Wildcat _____ Cable

Municipal well within one mile: _____ yes no

Depth to bottom of fresh water 280'

Depth to bottom of usable water 1700'

Surface pipe by Alternate: 1 _____ 2

Surface pipe planned to be set 300' MIN

Conductor pipe required

Projected Total Depth 5200' feet

Formation MARROW

If OWWO: old well info as follows:

Operator
Well Name
Comp Date Old Total Depth

I certify that well will comply with K.S.A. 55-101, et seq., plus eventually plugging hole to KCC specifications.

Date 12-8-86 Signature of Operator or Agent Steven K Mitchell

Title Petroleum Geologist

For KCC Use:

Conductor Pipe Required feet; Minimum Surface Pipe Required 300 feet per Alt. (2)


This Authorization Expires 6-15-87 Approved By [Signature] 12-15-86 [Signature]

Must be filed with the K.C.C. five (5) days prior to commencing well
This card void if drilling not started within six (6) months of date received by K.C.C.

Important procedures to follow:

1. Notify District office before setting surface casing.
2. Set surface casing by circulating cement to the top.
3. File completion forms ACO-1 with K.C.C. within 90 days of well completion, following instructions on ACO-1, side 1, and including copies of wireline logs.
4. Notify District office 48 hours prior to old well workover or re-entry.
5. Prior to filing Intent, prepare a proposed plugging plan in case well is D & A, then obtain approval of plan when calling district office prior to setting surface pipe.
6. Submit plugging report (CP-4) to K.C.C. after plugging is completed.
7. Obtain an approved injection docket number before disposing of salt water.
8. Notify K.C.C. within 10 days when injection commences or terminates.

**A Regular Section of Land
1 Mile = 5,280 Ft.**

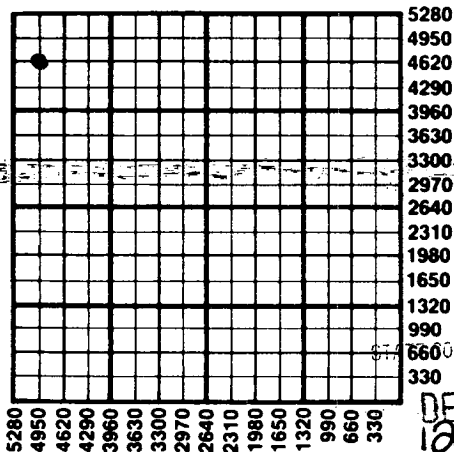

STATE CORPORATION COMMISSION

DEC 5 1986
12-05-86
CONSERVATION DIVISION
Wichita, Kansas

9. If an alternate 2 completion, cement in the production pipe from below any usable water to surface within 120 days of spud date.

DEC 15 1986
State Corporation Commission of Kansas
Conservation Division
200 Colorado Derby Building
Wichita, Kansas 67202
(316) 263-3238
CONSERVATION DIVISION
Wichita, Kansas