

# NOTICE OF INTENTION TO DRILL

(see rules on reverse side)

Starting Date ..... Feb. 20, 1987  
month day year

API Number 15- 071-20,434-00-00

OPERATOR: License # KCC 4034  
Name Remuda Corporation  
Address P.O. Box 7127  
City/State/Zip Billings, MT 59103-7127  
Contact Person Norm Brown  
Phone 303-830-0331

SW NE SW Sec. 8 Twp. 16 S, Rg. 42 East  
1820 W West  
3530 Ft. from South Line of Section  
Ft. from East Line of Section

(Note: Locate well on Section Plat on reverse side)

CONTRACTOR: License # KCC 6033  
Name Murfin Drilling Co.  
City/State Wichita, Kansas

Nearest lease or unit boundary line 820 feet  
County Greeley

Lease Name M.K. White Well # 1  
Ground surface elevation 3848 feet MSL

Well Drilled For: Well Class: Type Equipment:  
 Oil  SWD  Infield  Mud Rotary  
 Gas  Inj  Pool Ext.  Air Rotary  
 OWWO  Expl  Wildcat  Cable

Domestic well within 330 feet:  yes  no  
Municipal well within one mile:  yes  no  
Surface pipe by Alternate: 1  2  3

If OWWO: old well info as follows:

Depth to bottom of fresh water 240  
Depth to bottom of usable water 1750  
Surface pipe planned to be set 300  
Projected Total Depth 5250 feet  
Formation Morrow

Operator  
Well Name  
Comp Date Old Total Depth

I certify that well will comply with K.S.A. 55-101, et seq., plus eventually plugging hole to KCC specifications. Production casing will be cemented immed. upon completion

Alternate 3 cementing will be done immediately upon setting production casing of well from below usable water to surface.  
Date 2-12-87 Signature of Operator or Agent Edward F. [Signature] Title Vice President

For KCC Use:


Conductor Pipe Required ..... feet; Minimum Surface Pipe Required 300 feet per Alt. 400  
This Authorization Expires 8-17-87 Approved By 2-17-87 [Signature]

Must be filed with the K.C.C. five (5) days prior to commencing well  
This card void if drilling not started within six (6) months of date received by K.C.C.

**Important procedures to follow:**

1. Notify District office before setting surface casing.
2. Set surface casing by circulating cement to the top.
3. File completion forms ACO-1 with K.C.C. within 90 days of well completion, following instructions on ACO-1, side 1, and including copies of wireline logs.
4. Notify District office 48 hours prior to old well workover or re-entry.
5. Prior to filing Intent, prepare a proposed plugging plan in case well is D & A, then obtain approval of plan when calling district office prior to setting surface pipe.
6. Submit plugging report (CP-4) to K.C.C. after plugging is completed.
7. Obtain an approved injection docket number before disposing of salt water.
8. Notify K.C.C. within 10 days when injection commences or terminates.
9. If an alternate 2 completion, cement in the production pipe from below any usable water to surface within 120 days of spud date.

**A Regular Section of Land**  
**1 Mile = 5,280 Ft.**

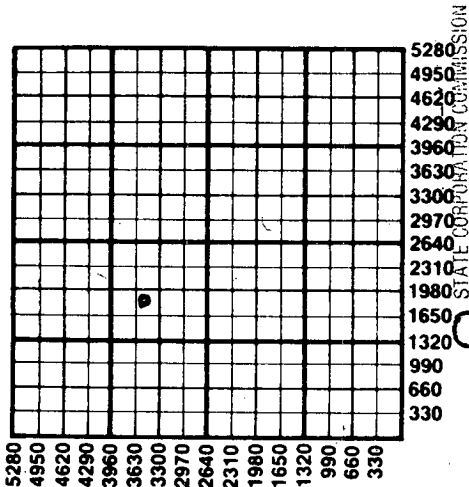

FEB 17 1957

CONSERVATION DIVISION  
Wichita, Kansas

02-17-87

State Corporation Commission of Kansas  
Conservation Division  
200 Colorado Derby Building  
Wichita, Kansas 67202  
(316) 263-3238