

CARD MUST BE TYPED

State of Kansas

CARD MUST BE SIGNED

NOTICE OF INTENTION TO DRILL

(see rules on reverse side)

Starting Date 1/3/89 month day year

API Number 15-169-20,301-0000

OPERATOR: License # 5330 Name Excalibur Production Co., Inc. Address P.O. Box 278 City/State/Zip McPherson, Kansas 67460 Contact Person Charles D. Johnson Phone (316) 241-4005 1265

Section C W/2 Sec 8 Twp 15 S Rg 1 West 2640 Ft. from South Line of Section 3960 Ft. from East Line of Section

(Note: Locate well on Section Plat on reverse side)

CONTRACTOR: License # 3890 Name Tornado Drilling, Inc. City/State Canton, Kansas 67428

Nearest lease or unit boundary line 1320 feet County Saline

Well Drilled For: Well Class: Type Equipment: Oil SWD Infield Mud Rotary Gas Inj Pool Ext Air Rotary OWWO Expl Wildcat Cable

Lease Name Swanson Well # 3 Ground surface elevation feet MSL Domestic well within 330 feet: yes no Municipal well within one mile: yes no Depth to bottom of fresh water 50' Depth to bottom of usable water 200' Surface pipe by Alternate: 1 20' Surface pipe planned to be set 200' Conductor pipe required N/A Projected Total Depth 2700' Formation Mississippi

If OWWO: old well info as follows: Operator Well Name Comp Date Old Total Depth

I certify that well will comply with K.S.A. 55-101, et seq., plus eventually plugging hole to KCC specifications. Date 12/21/88 Signature of Operator or Agent Charles D. Johnson Title President

For KCC Use: Conductor Pipe Required feet; Minimum Surface Pipe Required 200' feet per Alt. This Authorization Expires 9-17-89 Approved By LKM 3-17-89


EFFECTIVE DATE: 3-22-89

Must be filed with the K.C.C. five (5) days prior to commencing well
This card void if drilling not started within six (6) months of date received by K.C.C.

Important procedures to follow:

1. Notify District office before setting surface casing.
2. Set surface casing by circulating cement to the top.
3. File completion forms ACO-1 with K.C.C. within 90 days of well completion, following instructions on ACO-1, side 1, and including copies of wireline logs.
4. Notify District office 48 hours prior to old well workover or re-entry.
5. Prior to filing Intent, prepare a proposed plugging plan in case well is D & A, then obtain approval of plan when calling district office prior to setting surface pipe.
6. Submit plugging report (CP-4) to K.C.C. after plugging is completed.
7. Obtain an approved injection docket number before disposing of salt water.
8. Notify K.C.C. within 10 days when injection commences or terminates.

A Regular Section of Land
1 Mile = 5,280 Ft.

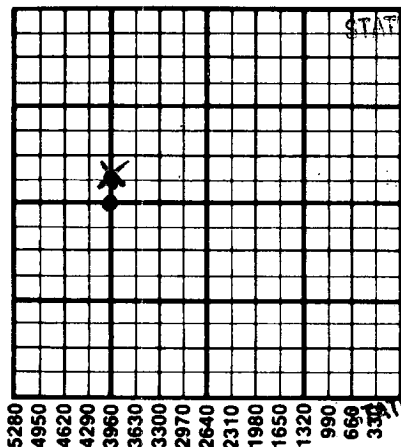

RECEIVED

MAR 01 1980

RECEIVED

DEC 22 1988
12-22-88

CONSERVATION DIVISION
Wichita, Kansas

State Corporation Commission of Kansas
Conservation Division
200 Colorado Derby Building
Wichita, Kansas 67202
(316) 263-3238